

City of Prince George
HISTORY SHEET

PID: 027542769

Scale: 1:500

Legal: LOT 25

D.L.: 1605

PLAN: BCP36464

Address: 7603 ST ANDREW COURT

Sanitary Connection:# SIZE: 100mmØ MATERIAL: PVC INV. 679.28m CONNECTED

Water Connection:# SIZE: 19mmØ MATERIAL: COPPER INV. 679.35m

Storm Connection:# SIZE: 100mmØ MATERIAL: PVC INV. 679.26m CONNECTED

Cash Receipt No's: WATER SANITARY STORM

CURB FROM PROPERTY LINE 5m PAVEMENT WIDTH 10m

B.C. HYDRO 75mm DB2 U/G CONNECTION ✓


B.C. TELEPHONE 50mm DB2 U/G CONNECTION ✓

B.C. GAS 42 PROP /P.E

Information Sheets: REF. DWGS. L&M ENGINEERING LTD. JOB. 1106-06-04 DWGS. (001-306)

Comments: CS CURB STOP SDW WATER SERVICE TCH HYDRO SERVICE
CO CLEAN OUT SDW STORM SERVICE TCH CABLE SERVICE
SDW SANITARY SERVICE TCH TELECOMMUNICATIONS GAS GAS
E ELECTRICAL

THE INFORMATION CONTAINED HEREIN IS FOR INTERNAL USE ONLY.
NOT TO BE RELIED UPON UNLESS CONFIRMED BY THE SITE INSPECTION AND/OR INVESTIGATION

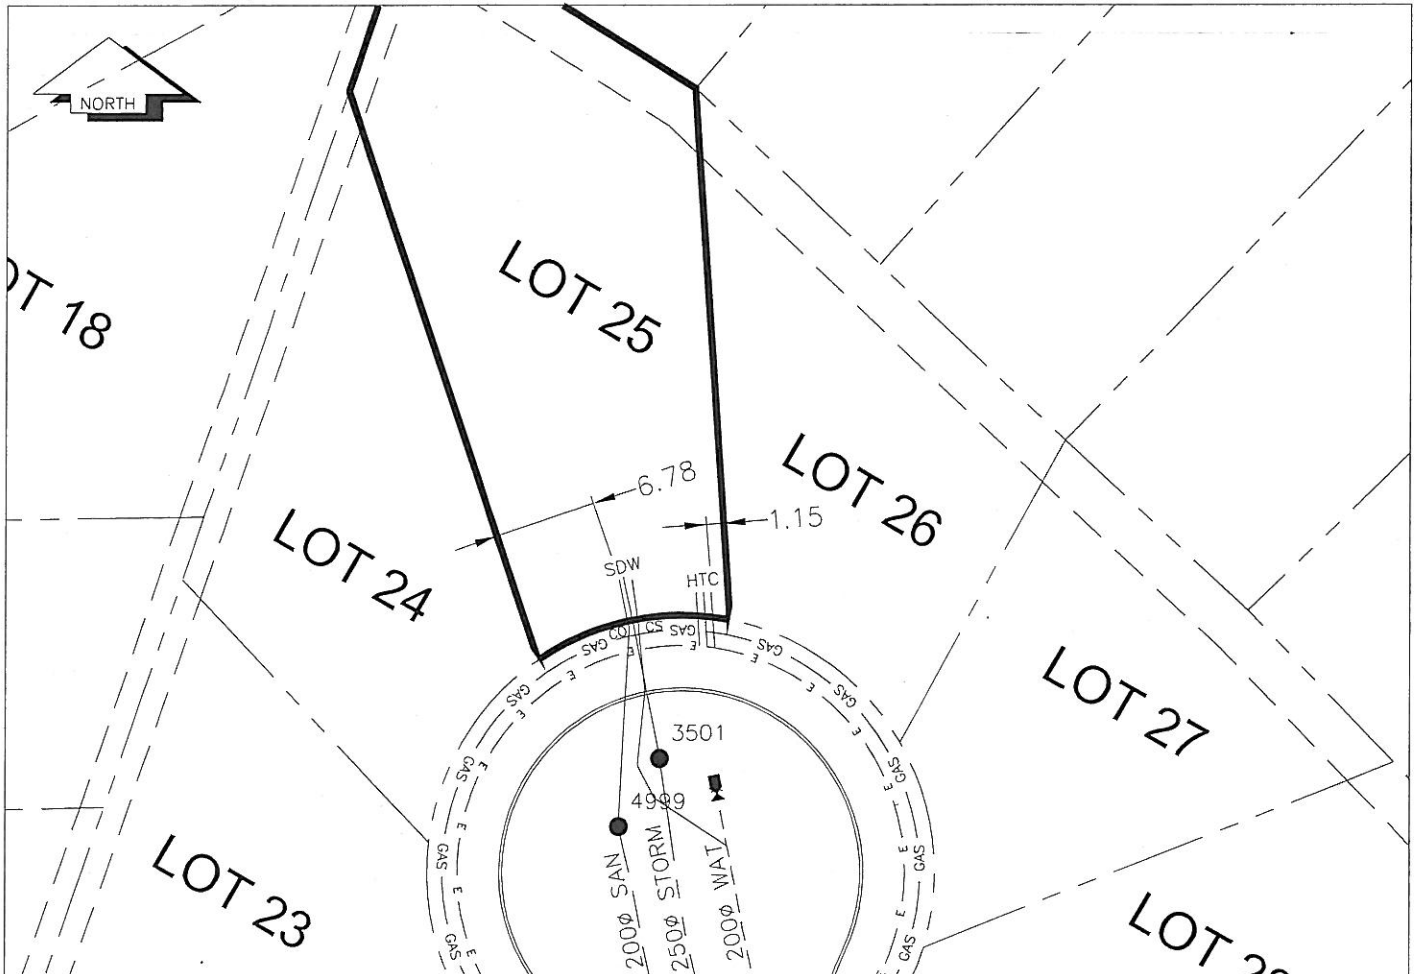

SANITARY, STORM & WATER SERVICE INVERTS	SANITARY	WATER	STORM
1. Distance from San. M.H. 4999 toward San. M.H. 4999 to lot service connection point is:	0m	N/A	N/A
1a. Distance from Strm. M.H. 3501 toward Strm. M.H. 3501 to lot service connection point is:	N/A	N/A	0m
2. Main Size at connection point is	200mmØ	200mmØ	250mmØ
3. Invert of main at conn. stub pt is	678.90m	678.03m	678.74m
4. Invert at service end is	679.28m	679.35m	679.26m
5. Cover at P/L in meters	2.3m	2.33m	2.32m
6. Survey Date: NOV,14,07 Book Ref.: 1106-06-03 By: FORESIGHT			

SANITARY HISTORY:

DATE INSTALLED: AUGUST 2007

INSTALLED BY: WESTERN INDUSTRIAL CONTRACTORS LTD

WATER HISTORY:

DATE INSTALLED: AUGUST 2007

INSTALLED BY: WESTERN INDUSTRIAL CONTRACTORS LTD

STORM HISTORY:

DATE INSTALLED: AUGUST 2007

INSTALLED BY: WESTERN INDUSTRIAL CONTRACTORS LTD