

# City of Prince George

## HISTORY SHEET

PID: 027542807

Scale: 1:500

Legal: LOT 29

D.L.: 1605

PLAN: BCP36464

Address: 8486 ST LAWRENCE AVE

Sanitary Connection:# SIZE: 100mmØ MATERIAL PVC INV. 674.22m CONNECTED

Water Connection:# SIZE: 19mmØ MATERIAL: COPPER INV. 674.23m

Storm Connection:# SIZE 100mmØ MATERIAL PVC INV. 674.18m CONNECTED

Cash Receipt No's: WATER SANITARY STORM

CURB FROM PROPERTY LINE 6m PAVEMENT WIDTH 13m

B.C. HYDRO 75mm DB2 U/G CONNECTION ✓

B.C. TELEPHONE 50mm DB2 U/G CONNECTION ✓


B.C. GAS 42 PROP /P.E

Information Sheets: REF. DWGS. L&M ENGINEERING LTD. JOB. 1106-06-04 DWGS. (001-306)

Comments: CS CURB STOP SDW WATER SERVICE TCH HYDRO SERVICE  
CO CLEAN OUT SDW STORM SERVICE TCH CABLE SERVICE  
SDW SANITARY SERVICE TCH TELECOMMUNICATIONS GAS GAS  
E ELECTRICAL

THE INFORMATION CONTAINED HEREIN IS FOR INTERNAL USE ONLY.

NOT TO BE RELIED UPON UNLESS CONFIRMED BY THE SITE INSPECTION AND/OR INVESTIGATION

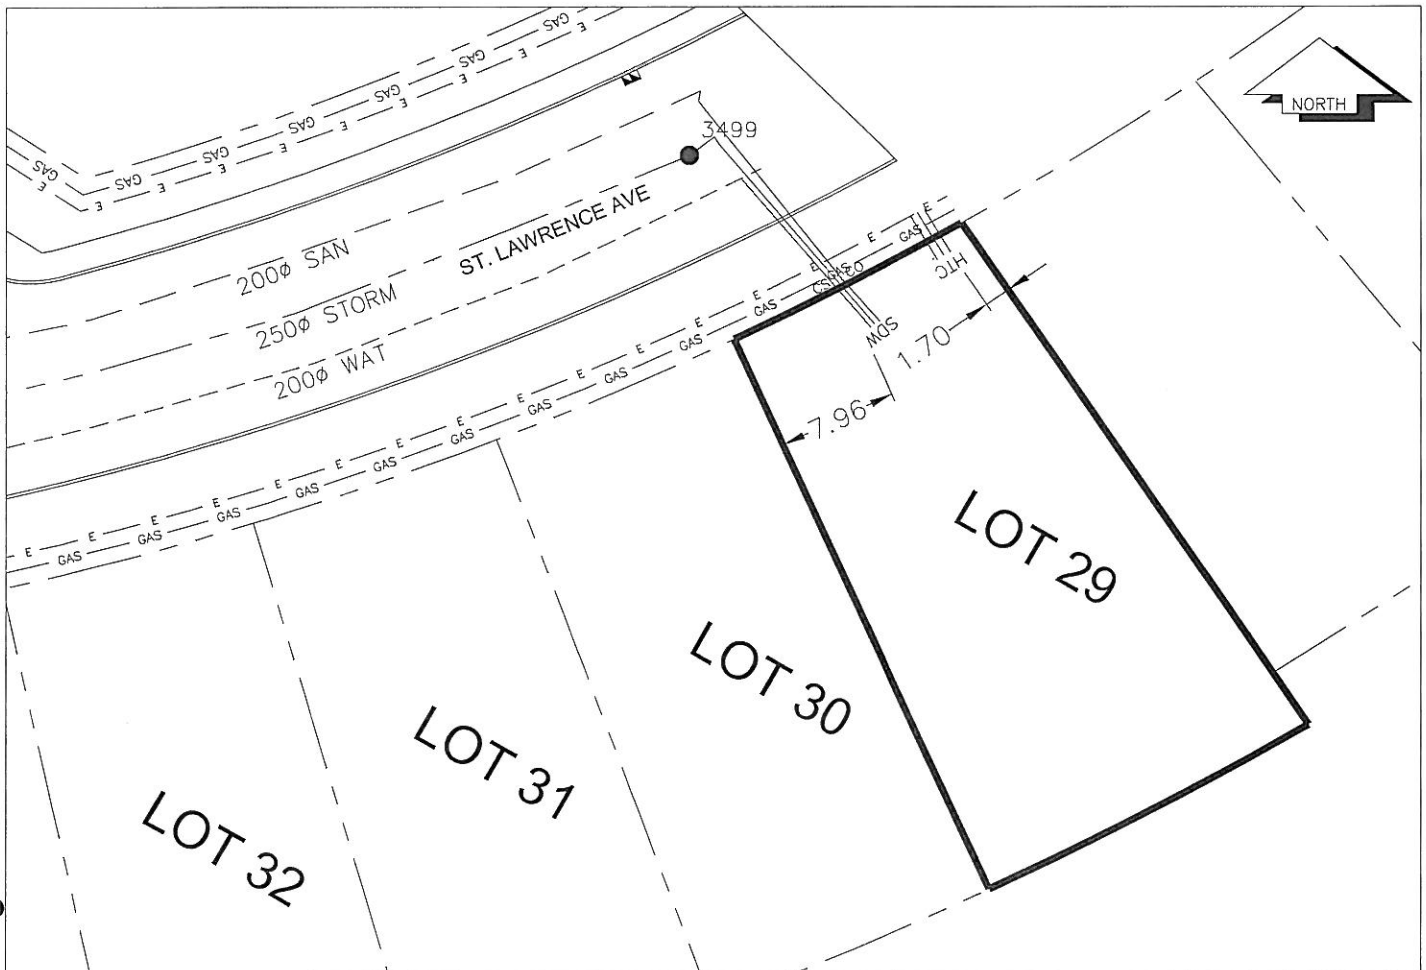

SANITARY, STORM & WATER SERVICE INVERTS	SANITARY	WATER	STORM
1. Distance from San. M.H. 5000 toward San. M.H. 4454 to lot service connection point is:	60m	N/A	N/A
1a.Distance from Stm. M.H. 3499 toward Stm. M.H. 3500 to lot service connection point is:	N/A	N/A	1m
2. Main Size at connection point is	200mmØ	200mmØ	250mmØ
3. Invert of main at conn. stub pt is	673.32m	673.74m	673.37m
4. Invert at service end is	674.22m	674.23m	674.18m
5. Cover at P/L in meters	2.67m	2.76m	2.71m
6. Survey Date: NOV,14,07 Book Ref.: 1106-06-03 By: FORESIGHT			

**SANITARY HISTORY:**

DATE INSTALLED: AUGUST 2007

INSTALLED BY: WESTERN INDUSTRIAL CONTRACTORS LTD

**WATER HISTORY:**

DATE INSTALLED: AUGUST 2007

INSTALLED BY: WESTERN INDUSTRIAL CONTRACTORS LTD

**STORM HISTORY:**

DATE INSTALLED: AUGUST 2007

INSTALLED BY: WESTERN INDUSTRIAL CONTRACTORS LTD