

City of Prince George

HISTORY SHEET

PID: 027542815

Scale: 1:500

Legal: LOT 30

D.L.: 1605

PLAN: BCP36464

Address: 8494 ST LAWRENCE AVE

Sanitary Connection:# SIZE: 100mmØ MATERIAL: PVC INV. 675.28m CONNECTED

Water Connection:# SIZE: 19mmØ MATERIAL: COPPER INV. 675.25m

Storm Connection:# SIZE: 100mmØ MATERIAL: PVC INV. 675.25m CONNECTED

Cash Receipt No's: WATER SANITARY STORM

CURB FROM PROPERTY LINE 6m PAVEMENT WIDTH 13m

B.C. HYDRO 75mm DB2 U/G CONNECTION ✓


B.C. TELEPHONE 50mm DB2 U/G CONNECTION ✓

B.C. GAS 42 PROP /P.E

Information Sheets: REF. DWGS. L&M ENGINEERING LTD. JOB. 1106-06-04 DWGS. (001-306)

Comments: CS CURB STOP SDW WATER SERVICE TCH HYDRO SERVICE
CO CLEAN OUT STORM SERVICE CABLE SERVICE
SANITARY SERVICE TELECOMMUNICATIONS GAS GAS
ELECTRICAL

THE INFORMATION CONTAINED HEREIN IS FOR INTERNAL USE ONLY.
NOT TO BE RELIED UPON UNLESS CONFIRMED BY THE SITE INSPECTION AND/OR INVESTIGATION

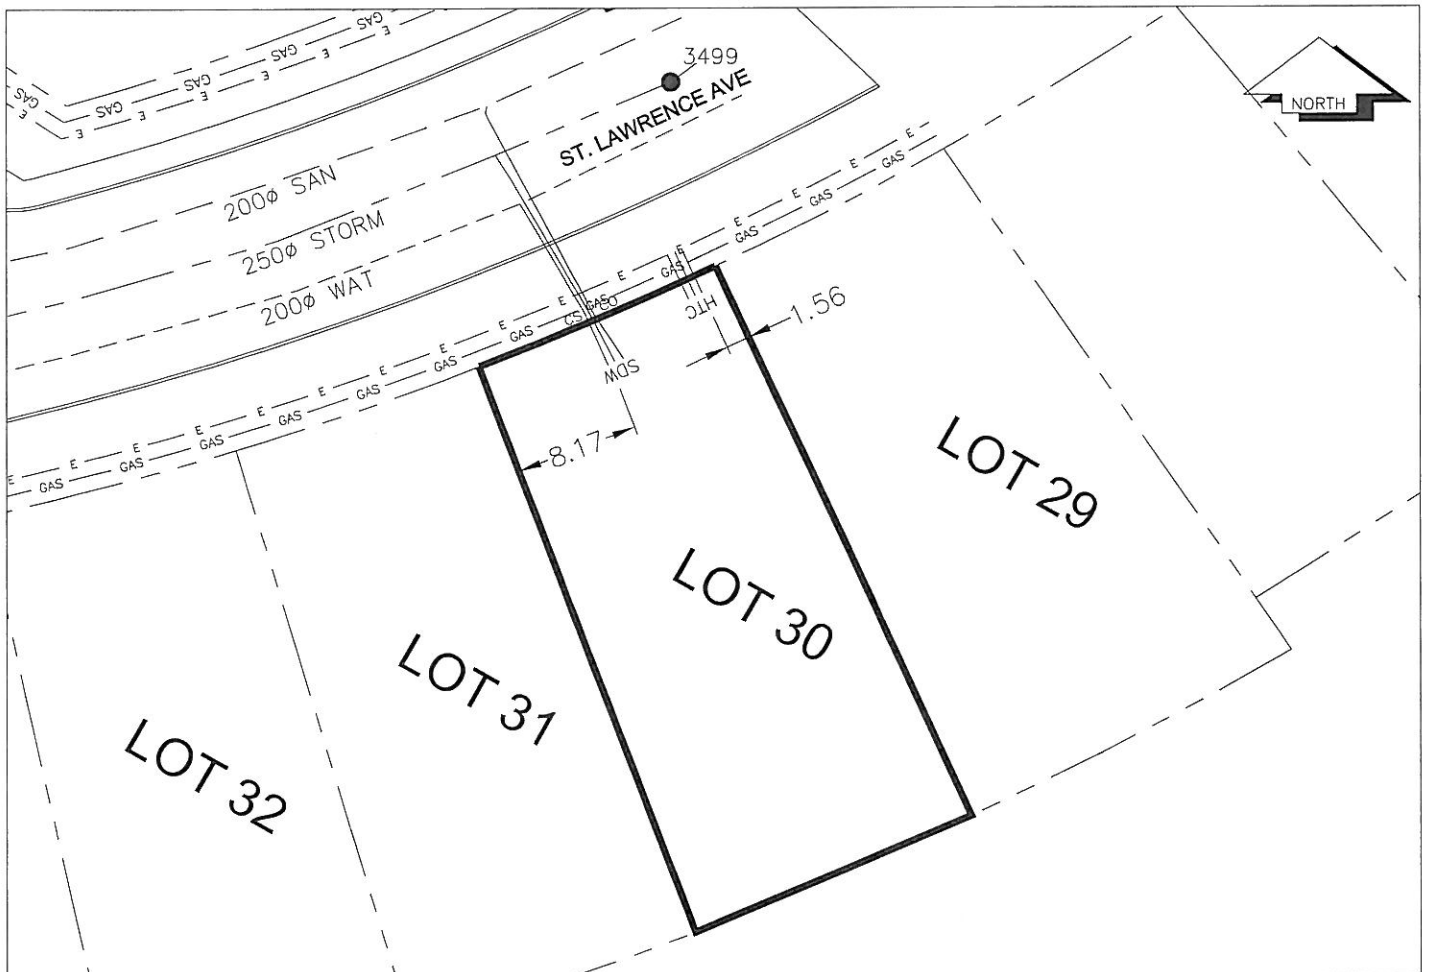

SANITARY, STORM & WATER SERVICE INVERTS	SANITARY	WATER	STORM
1. Distance from San. M.H. 5000 toward San. M.H. 4454 to lot service connection point is:	46m	N/A	N/A
1a. Distance from Stm. M.H. 3500 toward Stm. M.H. 3499 to lot service connection point is:	N/A	N/A	43m
2. Main Size at connection point is	200mmØ	200mmØ	250mmØ
3. Invert of main at conn. stub pt is	674.25m	674.56m	673.92m
4. Invert at service end is	675.28m	675.25m	675.25m
5. Cover at P/L in meters	2.64m	2.77m	2.67m
6. Survey Date: NOV,14,07 Book Ref.: 1106-06-03 By: FORESIGHT			

SANITARY HISTORY:

DATE INSTALLED: AUGUST 2007

INSTALLED BY: WESTERN INDUSTRIAL CONTRACTORS LTD

WATER HISTORY:

DATE INSTALLED: AUGUST 2007

INSTALLED BY: WESTERN INDUSTRIAL CONTRACTORS LTD

STORM HISTORY:

DATE INSTALLED: AUGUST 2007

INSTALLED BY: WESTERN INDUSTRIAL CONTRACTORS LTD