

City of Prince George

HISTORY SHEET

PID: 027542939

Scale: 1:500

Legal: LOT 42

D.L.: 1605

PLAN: BCP36464

Address: 8590 ST LAWRENCE AVE

Sanitary Connection:# SIZE: 100mmØ MATERIAL PVC INV. 687.77m CONNECTED

Water Connection:# SIZE: 19mmØ MATERIAL: COPPER INV. 687.77m

Storm Connection:# SIZE 100mmØ MATERIAL PVC INV. 687.78m CONNECTED

Cash Receipt No's: WATER SANITARY STORM

CURB FROM PROPERTY LINE 6m PAVEMENT WIDTH 13m

B.C. HYDRO 75mm DB2 U/G CONNECTION ✓


B.C. TELEPHONE 50mm DB2 U/G CONNECTION ✓

B.C. GAS 42 PROP /P.E

Information Sheets: REF. DWGS. L&M ENGINEERING LTD. JOB. 1106-06-04 DWGS. (001-306)

Comments: CS_o CURB STOP SDW WATER SERVICE TCH HYDRO SERVICE GAS GAS
CO CLEAN OUT SANITARY SERVICE TCH CABLE SERVICE TELECOMMUNICATIONS E ELECTRICAL

THE INFORMATION CONTAINED HEREIN IS FOR INTERNAL USE ONLY.
NOT TO BE RELIED UPON UNLESS CONFIRMED BY THE SITE INSPECTION AND/OR INVESTIGATION

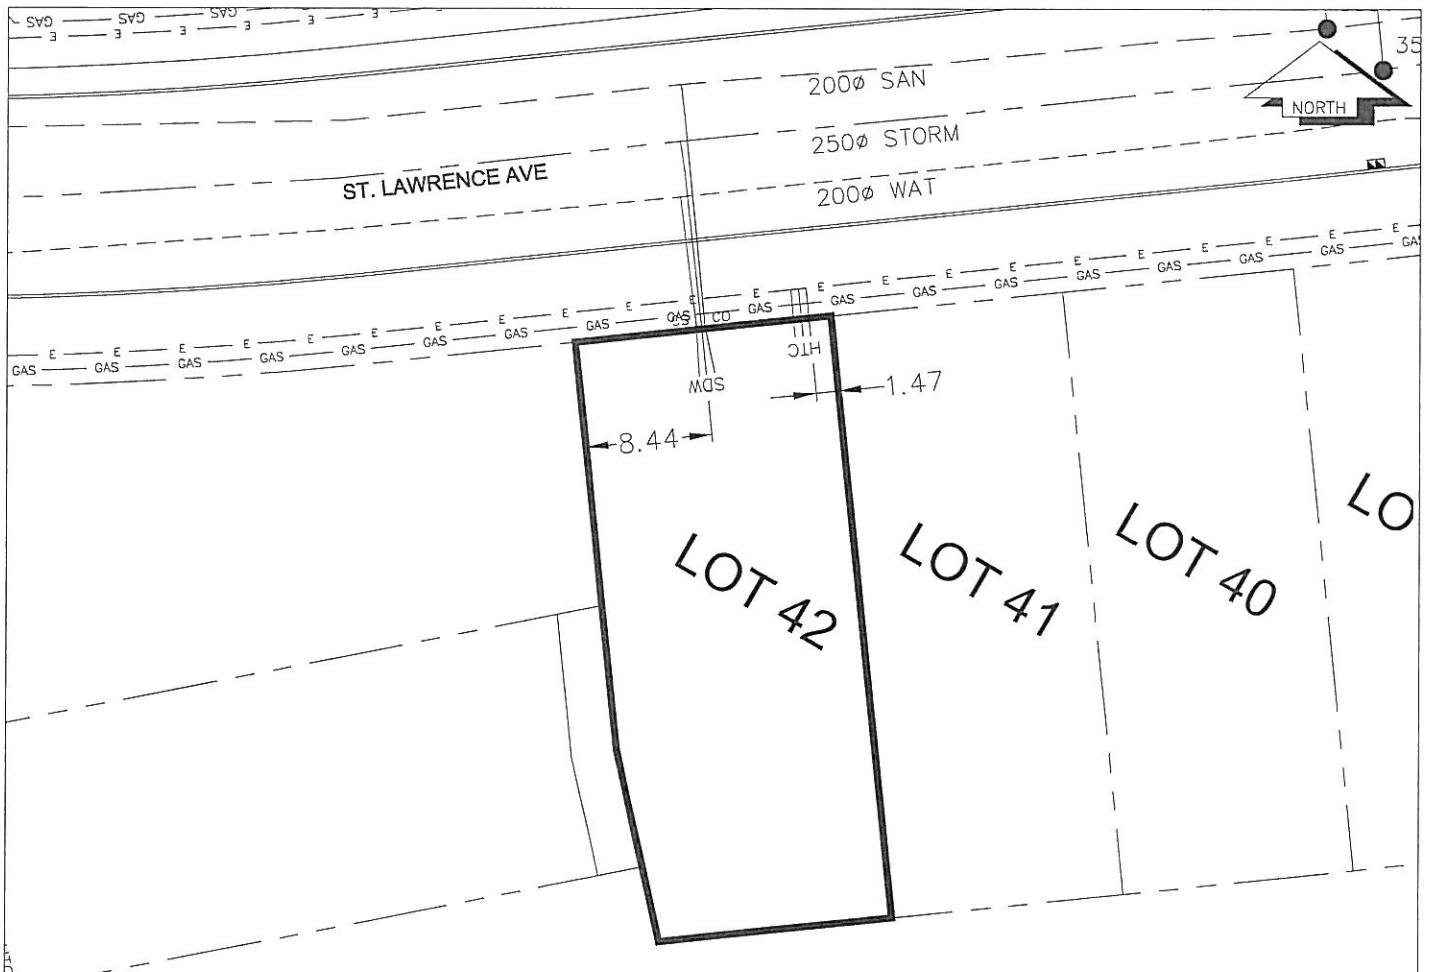

SANITARY, STORM & WATER SERVICE INVERTS	SANITARY	WATER	STORM
1. Distance from San. M.H. 5001 toward San. M.H. 5004 to lot service connection point is:	43m	N/A	N/A
1a.Distance from Strm. M.H. 3502 toward Strm. M.H. 3504 to lot service connection point is:	N/A	N/A	47m
2. Main Size at connection point is	200mmØ	200mmØ	250mmØ
3. Invert of main at conn. stub pt is	684.87m	687.01m	686.14m
4. Invert at service end is	687.77m	687.87m	687.78m
5. Cover at P/L in meters	2.36m	2.46m	2.35
6. Survey Date: NOV,04,07 Book Ref.: 1106-06-03 By: FORESIGHT			

SANITARY HISTORY:

DATE INSTALLED: AUGUST 2007

INSTALLED BY: WESTERN INDUSTRIAL CONTRACTORS LTD

WATER HISTORY:

DATE INSTALLED: AUGUST 2007

INSTALLED BY: WESTERN INDUSTRIAL CONTRACTORS LTD

STORM HISTORY:

DATE INSTALLED: AUGUST 2007

INSTALLED BY: WESTERN INDUSTRIAL CONTRACTORS LTD