


Lot Servicing

4292 22ND AVE

PID: 027552055

Lot: **1**, Plan: **BCP36922**, DL: **2611**

SERVICE	SIZE	MATERIAL	INSTALLED DATE	LOCATION	DETAILS
WATER	25MM	CU	24-Mar-1997	25.717M W OF SE COR PL	CASH RECEIPT NUMBER 19812
SANITARY	100MM	PVC	01-Jan-1997	24.817M W OF SE COR PL	CUT @ P/L @ DATE OF INSTALLATION 3.8M

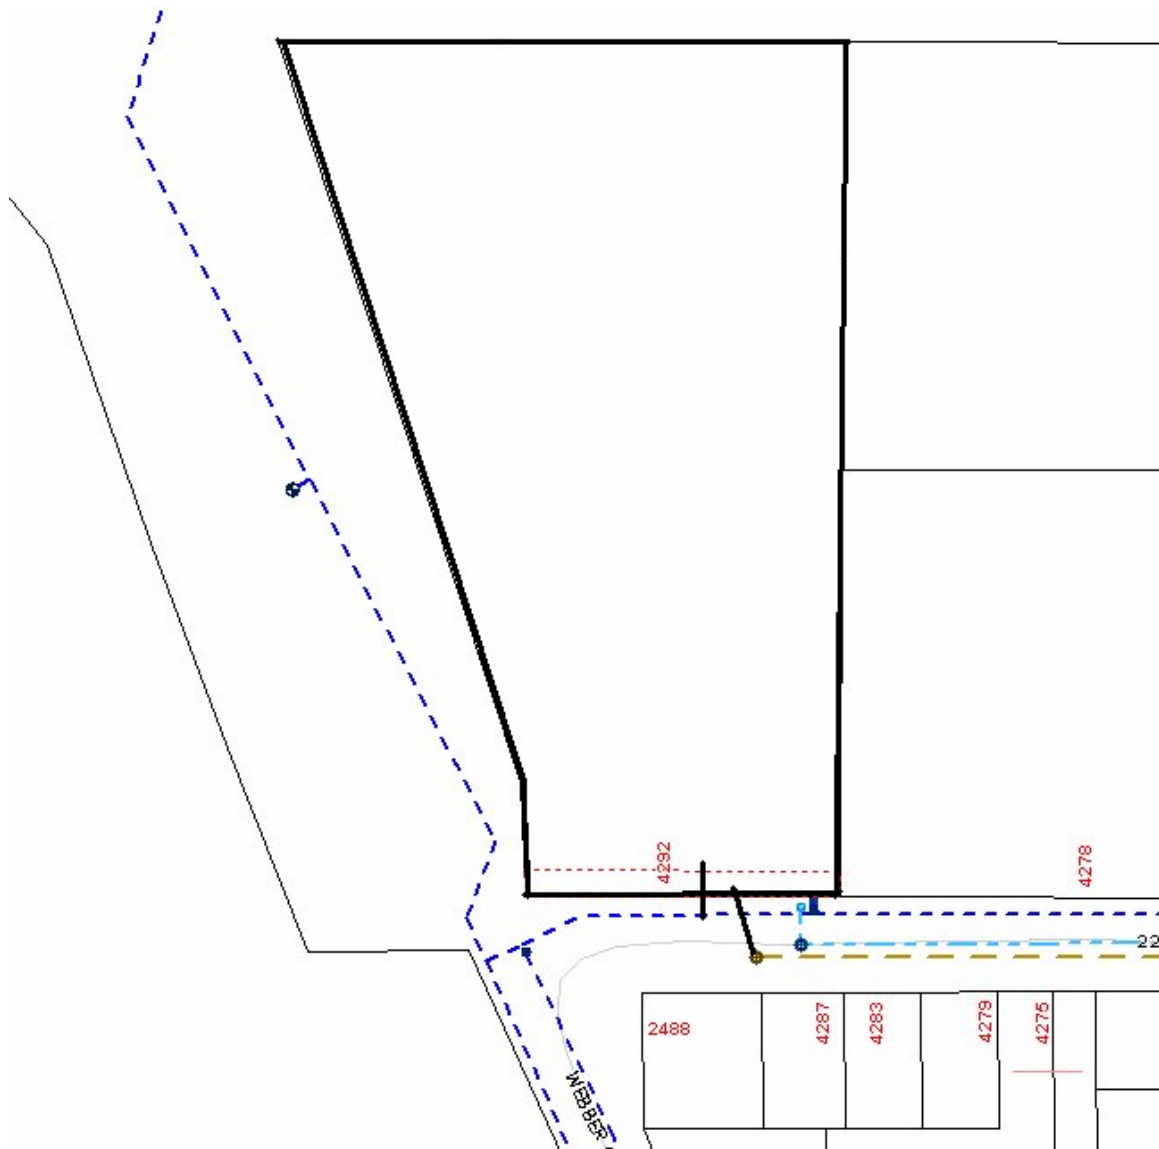

Accuracy not guaranteed unless confirmed by site inspection and/or investigation.
Connection location between main and property line only.