


Lot Servicing

2834 ANDRES RD

PID: 027565165

Lot: B, Plan: BCP37159, DL: 1433

SERVICE	SIZE	MATERIAL	INSTALLED DATE	LOCATION	DETAILS
WATER	20MM	CU	20-Oct-1991	.66M W E PL	
SANITARY	100MM	PVC	20-Oct-1991	.66M E W PL	RECEIPT # 8661

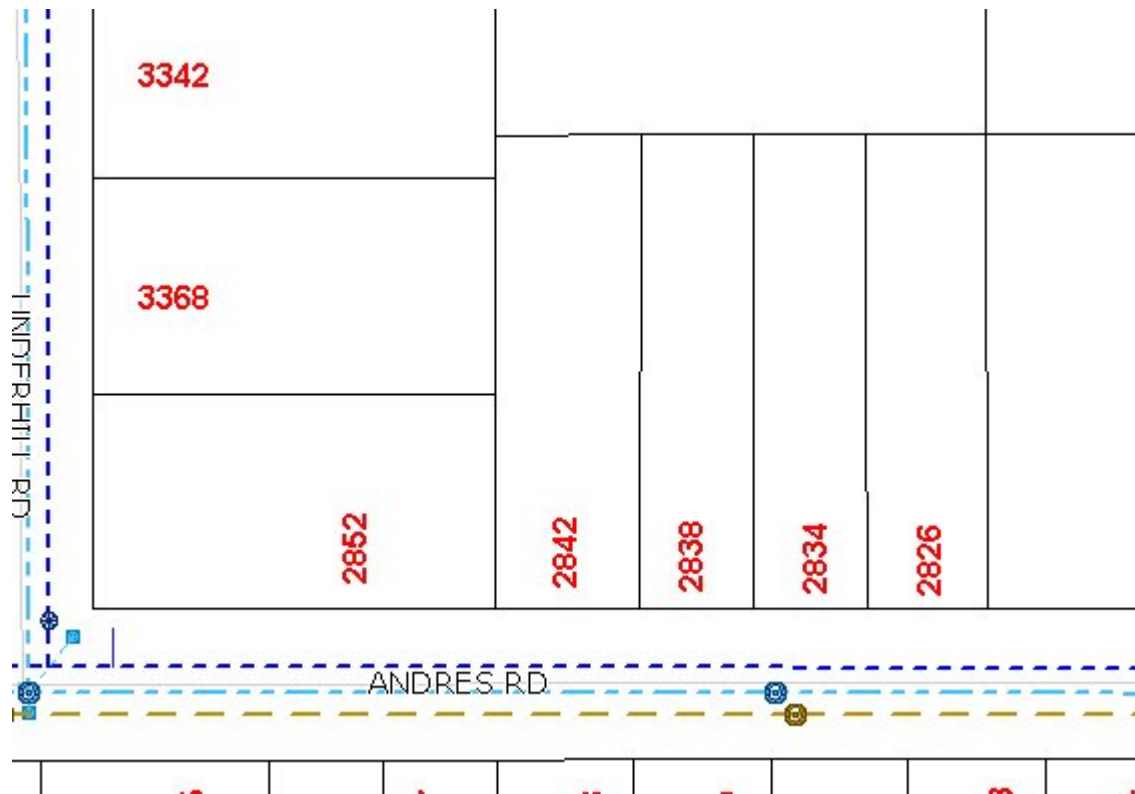

Accuracy not guaranteed unless confirmed by site inspection and/or investigation.
Connection location between main and property line only.