
## **Lot Servicing**

1977 CLEARWOOD CRES PID: 027566331

Lot: 1, Plan: BCP37211, DL: 4040

SERVICE	SIZE		INSTALLED DATE	LOCATION	DETAILS
WATER	20MM	CU		5.21M E OF NW COR PL ; FR NE COR GARAGE 4.4M N 2.9M W	
SANITARY	100MM	PVC		113 89M W OF NE COR PL	ELEV OF INVERT @ P/L 653.472

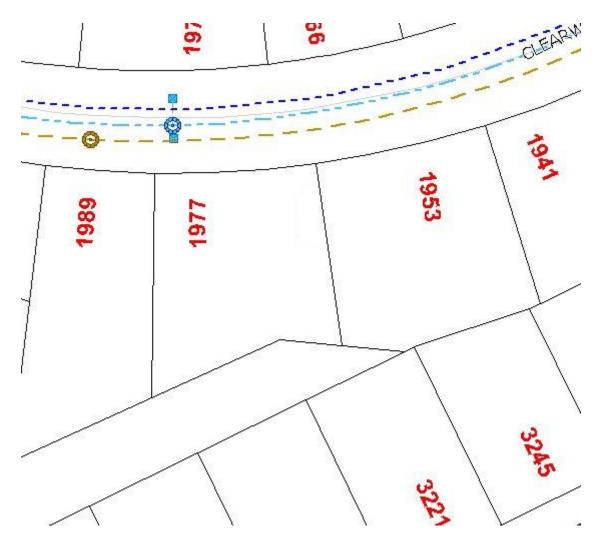

Accuracy not guaranteed unless confirmed by site inspection and/or investigation. Connection location between main and property line only.