
Lot Servicing

1953 CLEARWOOD CRES Lot: A, Plan: BCP37212, DL: 4040

PID: 027566404

SERVICE	SIZE	MATERIAL	INSTALLED DATE	LOCATION	DETAILS
WATER	20MM	си		26.815M E OF NW COR PL ; FR NE COR BLD 13.5M N	
SANITARY	100MM	PVC		3.41M W OF NE COR PL. 3.2M S	CLEANOUT SE COR 2M W 4M S

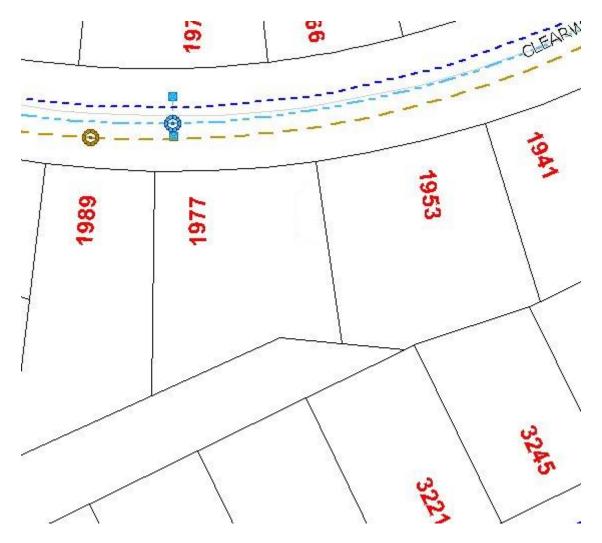

Accuracy not guaranteed unless confirmed by site inspection and/or investigation. Connection location between main and property line only.