


Lot Servicing

2855 PARENT RD

PID: 027577520

Lot: B, Plan: BCP37285, DL: 754

SERVICE	SIZE	MATERIAL	INSTALLED DATE	LOCATION	DETAILS
WATER	20MM	CU	18-Nov-1993	11.616M E OF W PL	CASH RECEIPT NUMBER 11282
SANITARY	100MM	PVC	18-Nov-1993	11.616M E OF W PL	DIFF OR CUT BELOW @ P/L 2.369
STORM	100MM	PVC	18-Nov-1993	11.616M E OF W PL	DIFF OR CUT @ P/L 2.269

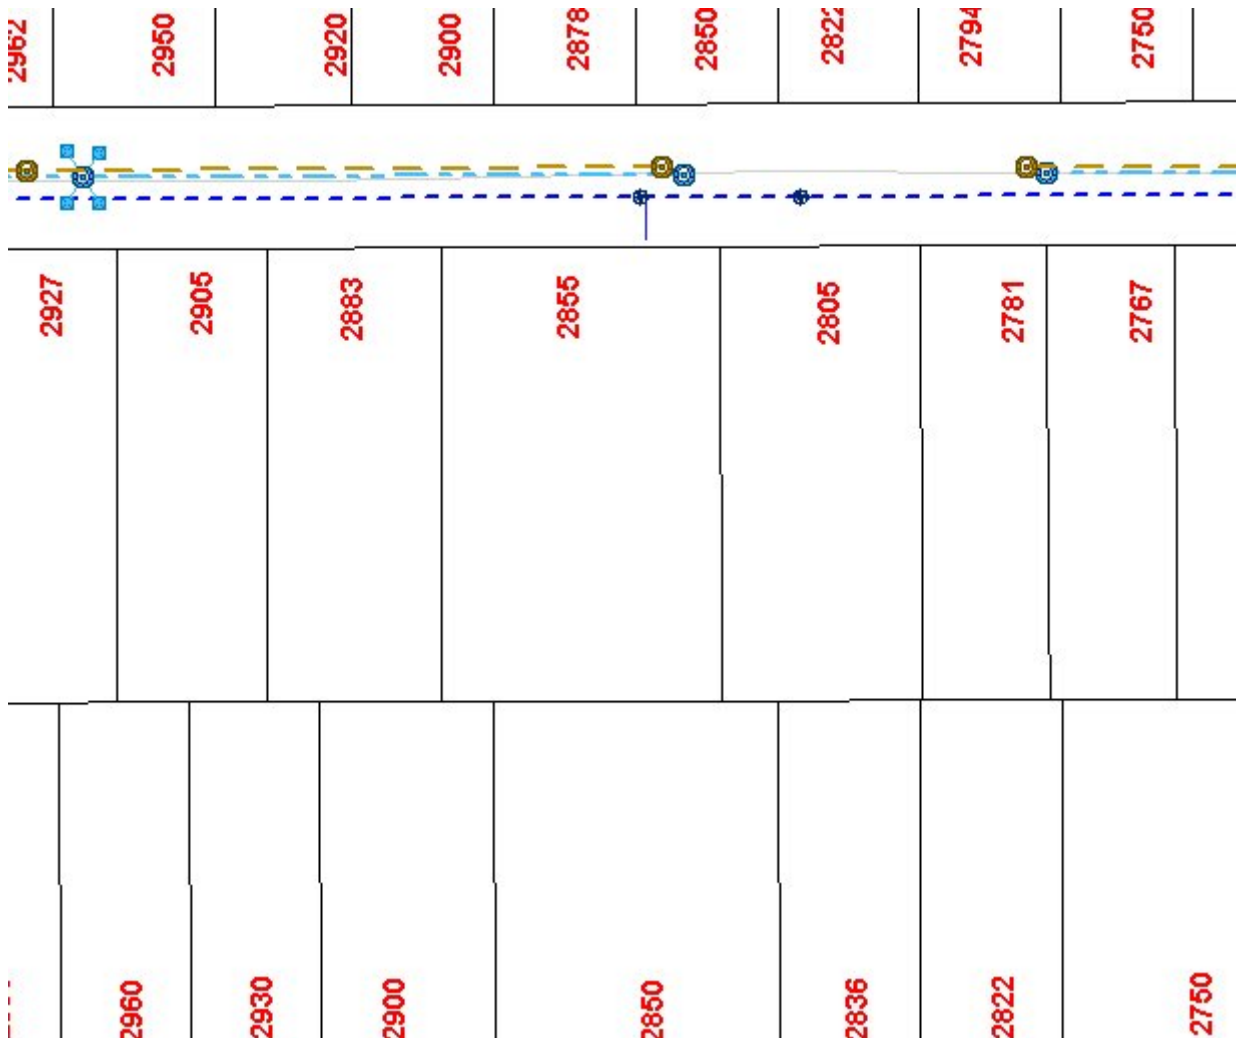

Accuracy not guaranteed unless confirmed by site inspection and/or investigation.
Connection location between main and property line only.

