


Lot Servicing

4956 POTY RD

PID: 027595617

Lot: PCL 1, **Plan:** BCP37578, **DL:** 954

SERVICE	SIZE	MATERIAL	INSTALLED DATE	LOCATION	DETAILS
WATER	20MM	UNKNOWN		3.4M E OF SW COR PL	CASH RECEIPT NUMBER PD.FEB.1968
WATER	NO SERVICE	NO SERVICE		NO SERVICE	
SANITARY	100MM	PVC		NO LOCATION	CONNECTION # 10082

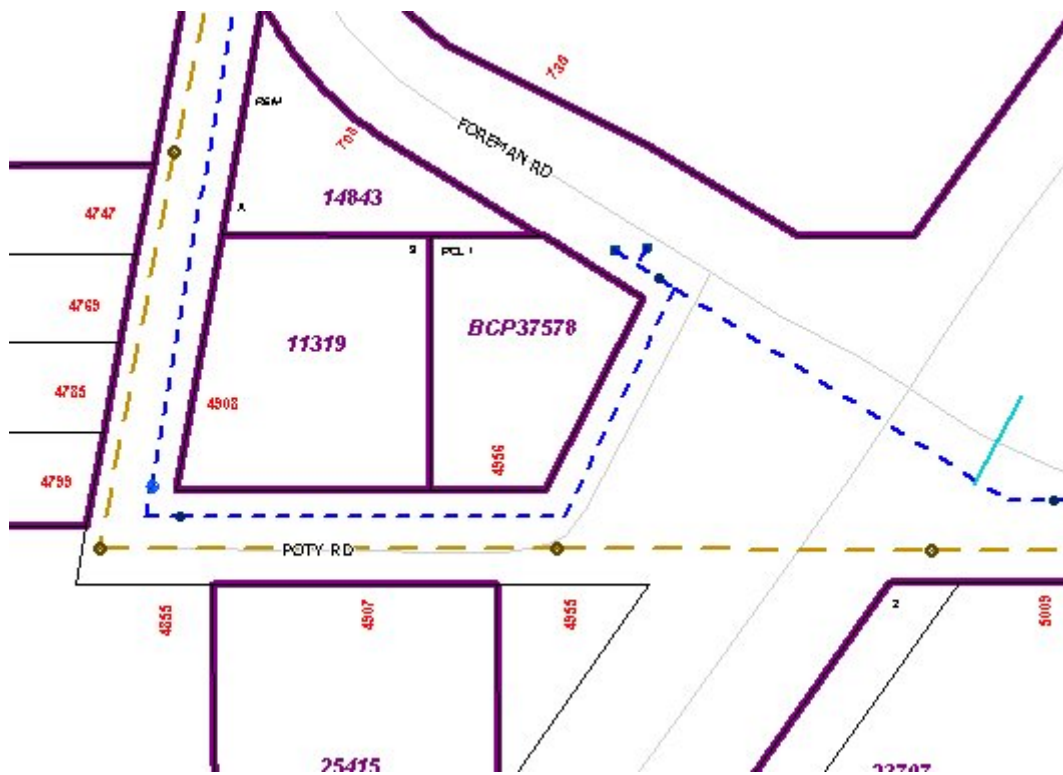

Accuracy not guaranteed unless confirmed by site inspection and/or investigation.
Connection location between main and property line only.