



# City of Prince George History Sheet

PID:	027615006
SD:	100460
WO:	

Civic Address: 2689 Links Dr

Legal Description: Lot: 16 District Lot: 4377 Plan: BCP37759


Service Type	Diameter (mm)	Material	Invert Elev at main (m)	Invert Elev at property line (m)	Invert Elev at service end (m)	Distance into property (m)	Installation Date
Sanitary	100mm	PVC	651.39	652.30	2.39	-	August 2008
Water	20mm	Copper	-	-	-	-	August 2008
Storm	100mm	PVC	-	652.30	2.39	-	August 2008

Service Connection Location				Sanitary (m)	Storm (m)
Distance from downstream San MH	5039	towards upstream San MH	5038	6.02	
Distance from downstream Stm MH	3556	towards upstream Stm MH	3555		6.57

Power	Size	Communications	Size	Cable	Size	Gas	Size
BC Hydro	-	Telus	-	Shaw	-	FortisBC	-
Underground Service		Underground Service		Underground Service			

Installed by:	Survey Date:	-
Comments:	Water service located on June 2017	

**NOT TO SCALE** The information contained herein is for internal use only.  
Not to be relied on unless confirmed by site inspection and/or investigation.

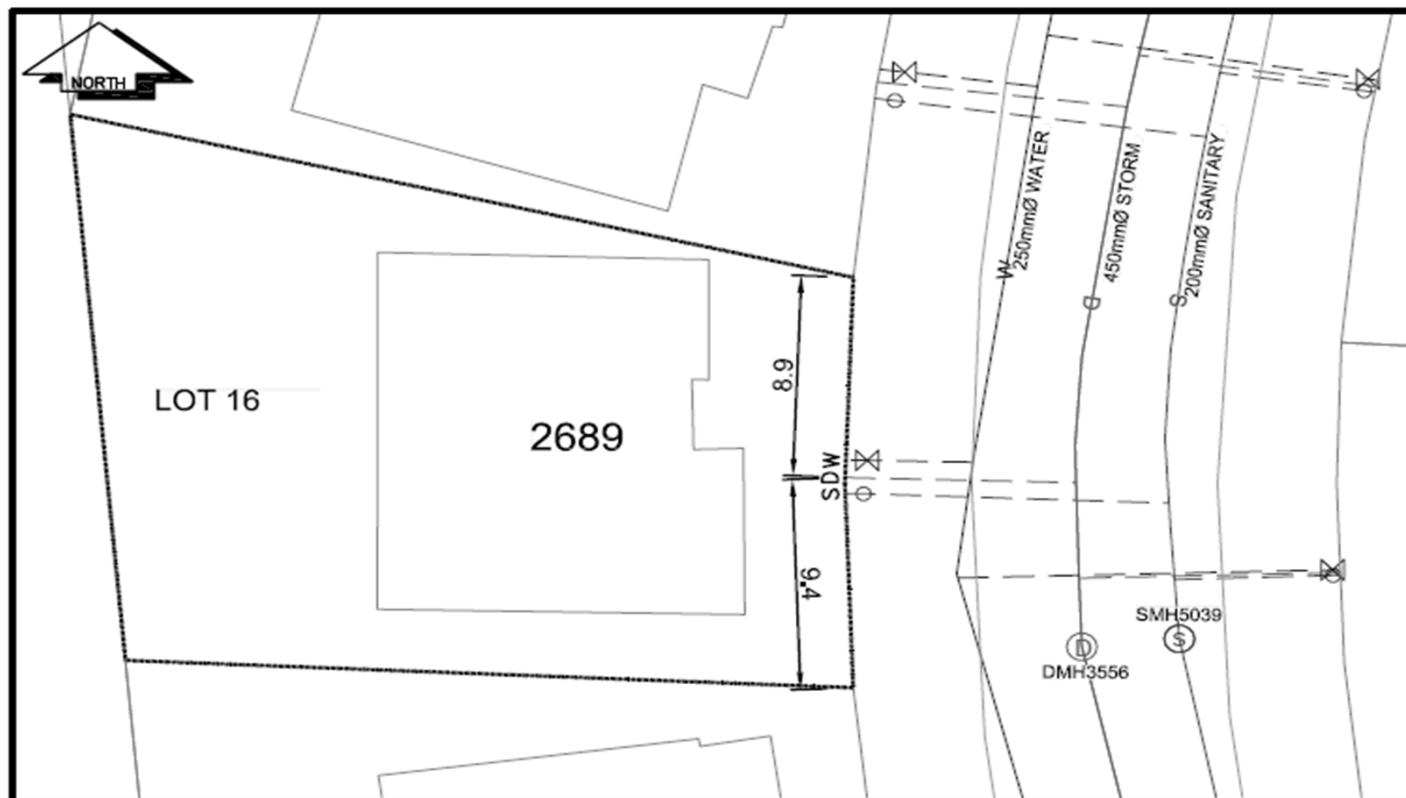

<b>LEGEND:</b>	CS <sup>o</sup> CURB STOP	--- W WATER SERVICE	--- S STORM SERVICE
	CO <sup>o</sup> CLEAN OUT	--- S SANITARY SERVICE	--- G GAS
	X WATER VALVE	X-FIRE HYDRANT	--- ENCUMBRANCE

**NOT TO SCALE**