


Lot Servicing

1064 GREAT ST

PID: 027633144

Lot: A, Plan: BCP37919, DL: 745

SERVICE	SIZE	MATERIAL	INSTALLED DATE	LOCATION	DETAILS
WATER	40MM	CU	30-May-1995	FR SE COR BLDG 28.0M E 2.0M S MID LOT	CASH RECEIPT NUMBER 14397
WATER	50MM	UNKNOWN	12-Oct-2000	6.0M S OF N PL	CASH RECEIPT NUMBER 100042
WATER	25MM	CU		141.445M S OF N PL	
SANITARY	100MM	UNKNOWN	03-Dec-1979	NO LOCATION GIVEN	CONNECTION # 12647
SANITARY	100MM	UNKNOWN	26-Aug-1981	134.665M S OF N PL	CONNECTION # 15214

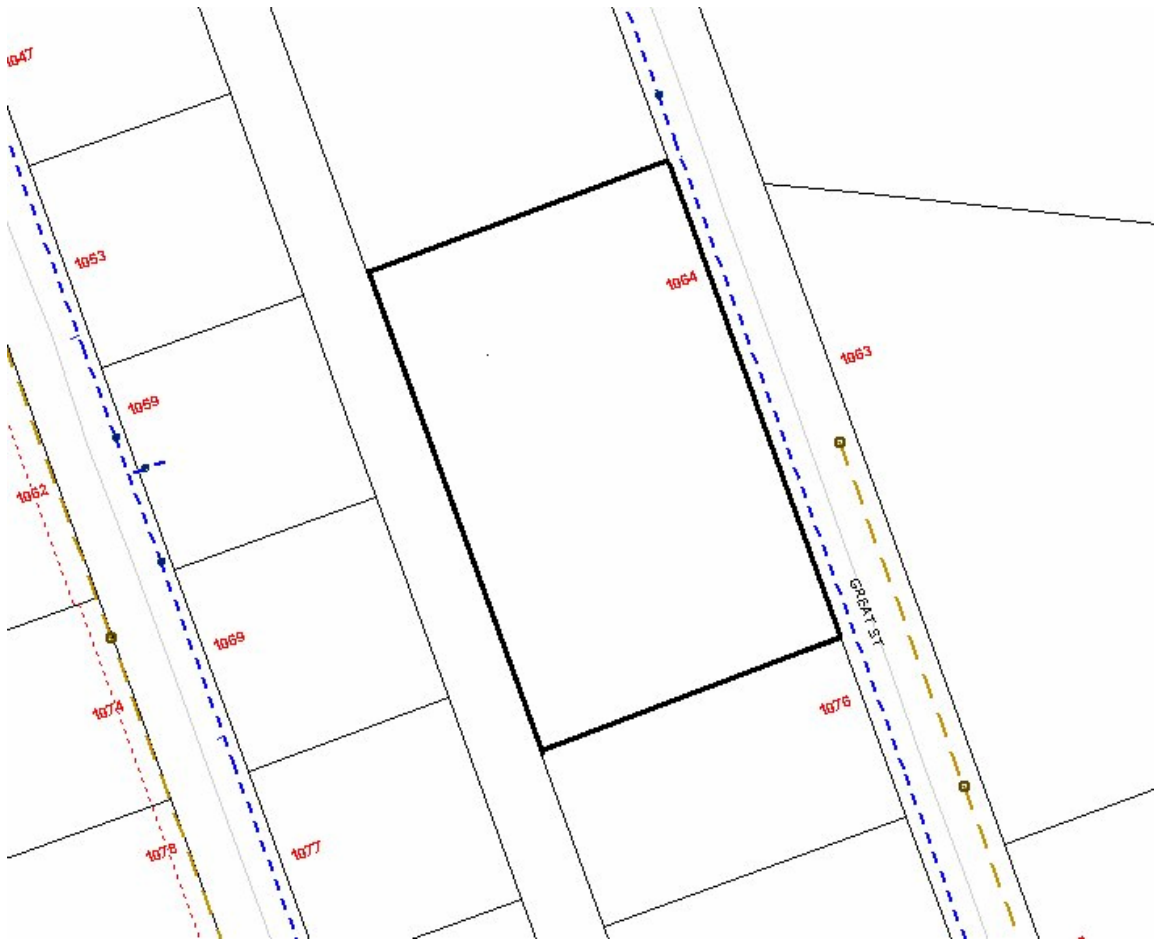

Accuracy not guaranteed unless confirmed by site inspection and/or investigation.
Connection location between main and property line only.