


## Lot Servicing

2104 NORWOOD ST

PID: 027647391

Lot: A, Plan: BCP37977, DL: 931

SERVICE	SIZE	MATERIAL	INSTALLED DATE	LOCATION	DETAILS
WATER	20MM	CU	28-Aug-1993	5.0M S OF N PL SP 7.1M S OF N PL	CASH RECEIPT NUMBER 11350
SANITARY	100MM	PVC	28-Aug-1993	5.0M S OF N PL	CLEANOUT 8.3M N OF S PL

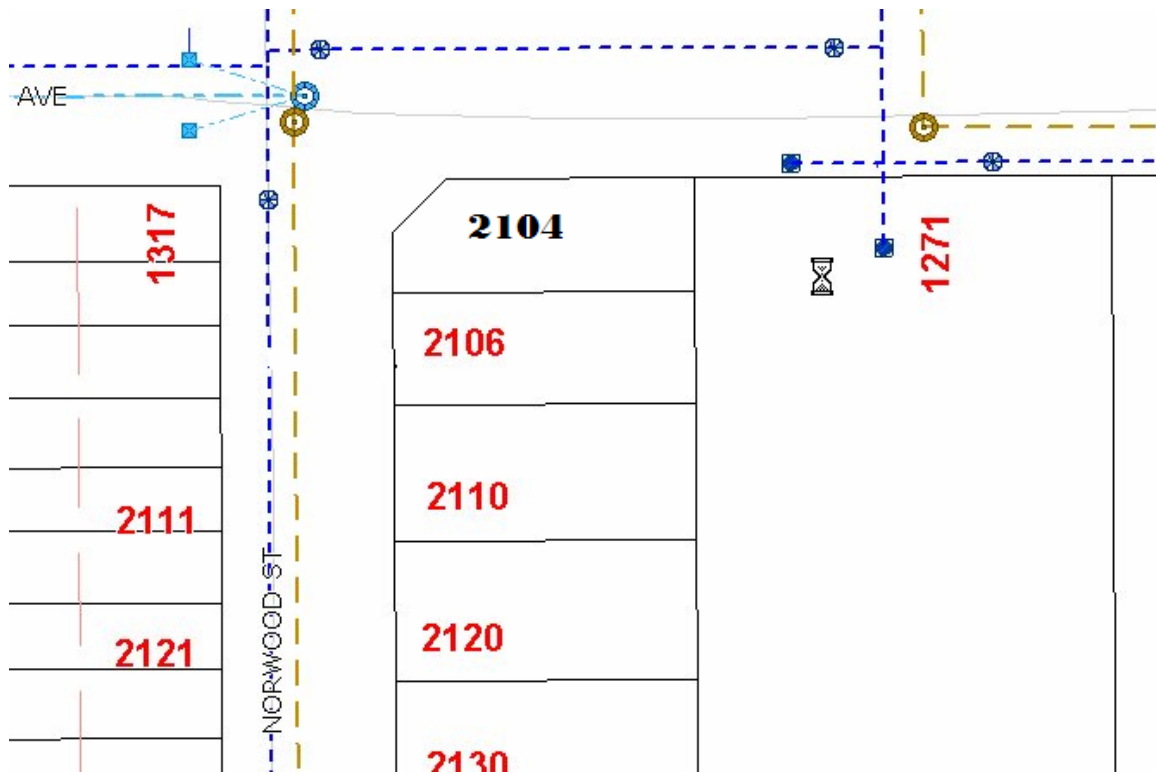

Accuracy not guaranteed unless confirmed by site inspection and/or investigation.  
Connection location between main and property line only.