


Lot Servicing

2106 NORWOOD ST

PID: 027647404

Lot: B, Plan: BCP37977, DL: 931

SERVICE	SIZE	MATERIAL	INSTALLED DATE	LOCATION	DETAILS
WATER	20MM	CU		6.381M N OF S PL SP 6.3M N OF S PL	
SANITARY	100MM	PVC		6.381M N OF S PL	CLEANOUT 5.3M N OF S PL

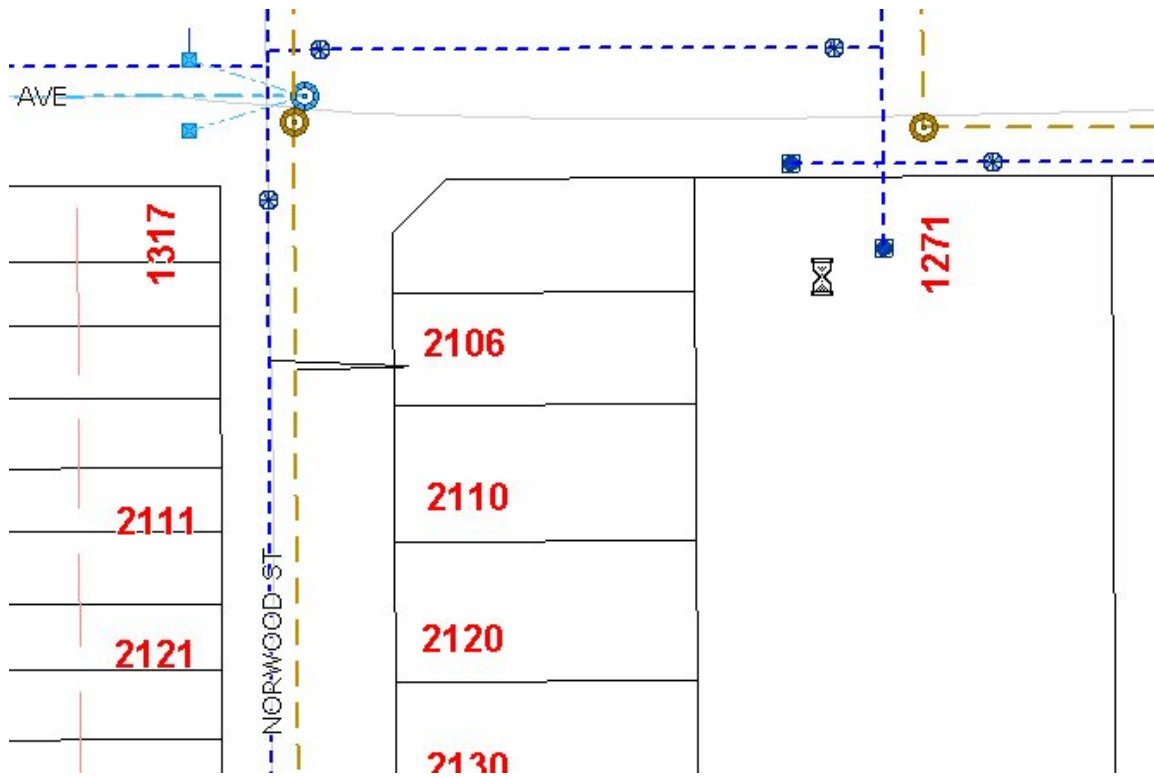

Accuracy not guaranteed unless confirmed by site inspection and/or investigation.
Connection location between main and property line only.