

City of Prince George

HISTORY SHEET

PID: 027662152

Scale: 1:1500

Legal: LOT 1

D.L. 485/745

PLAN BCP 38207

Address: 990 RAILWAY ROAD + 998 Railway Road

Sanitary Connection:# SIZE: 100mmØ MATERIAL: N/A INV. N/A CONNECTED

Water Connection:# SIZE: 150mmØ MATERIAL: A.C. INV. N/A METER

Storm Connection:# SIZE: 375mmØ MATERIAL: PVC INV. 590.90m CONNECTED

Cash Receipt No's: WATER SANITARY STORM

CURB FROM PROPERTY LINE 5.0m PAVEMENT WIDTH 13.0m

B.C. HYDRO N/A U/G CONNECTION ✓

B.C. TELEPHONE N/A U/G CONNECTION ✓


B.C. GAS N/A

Information Sheets: REF. DWGS. L&M ENGINEERING LIMITED JOB NO. 1126-13-03.3 (001AB-402AB)

Comments: CS CURB STOP CO CLEAN OUT W/S WATER SERVICE S/S STORM SERVICE S/S SANITARY SERVICE T/H HYDRO SERVICE C/H CABLE SERVICE T/H TELECOMMUNICATIONS S/S STORM MAIN S/S SANITARY MAIN S/S WATER MAIN GAS ELECTRICAL

THE INFORMATION CONTAINED HEREIN IS FOR INTERNAL USE ONLY.

NOT TO BE RELIED UPON UNLESS CONFIRMED BY THE SITE INSPECTION AND/OR INVESTIGATION

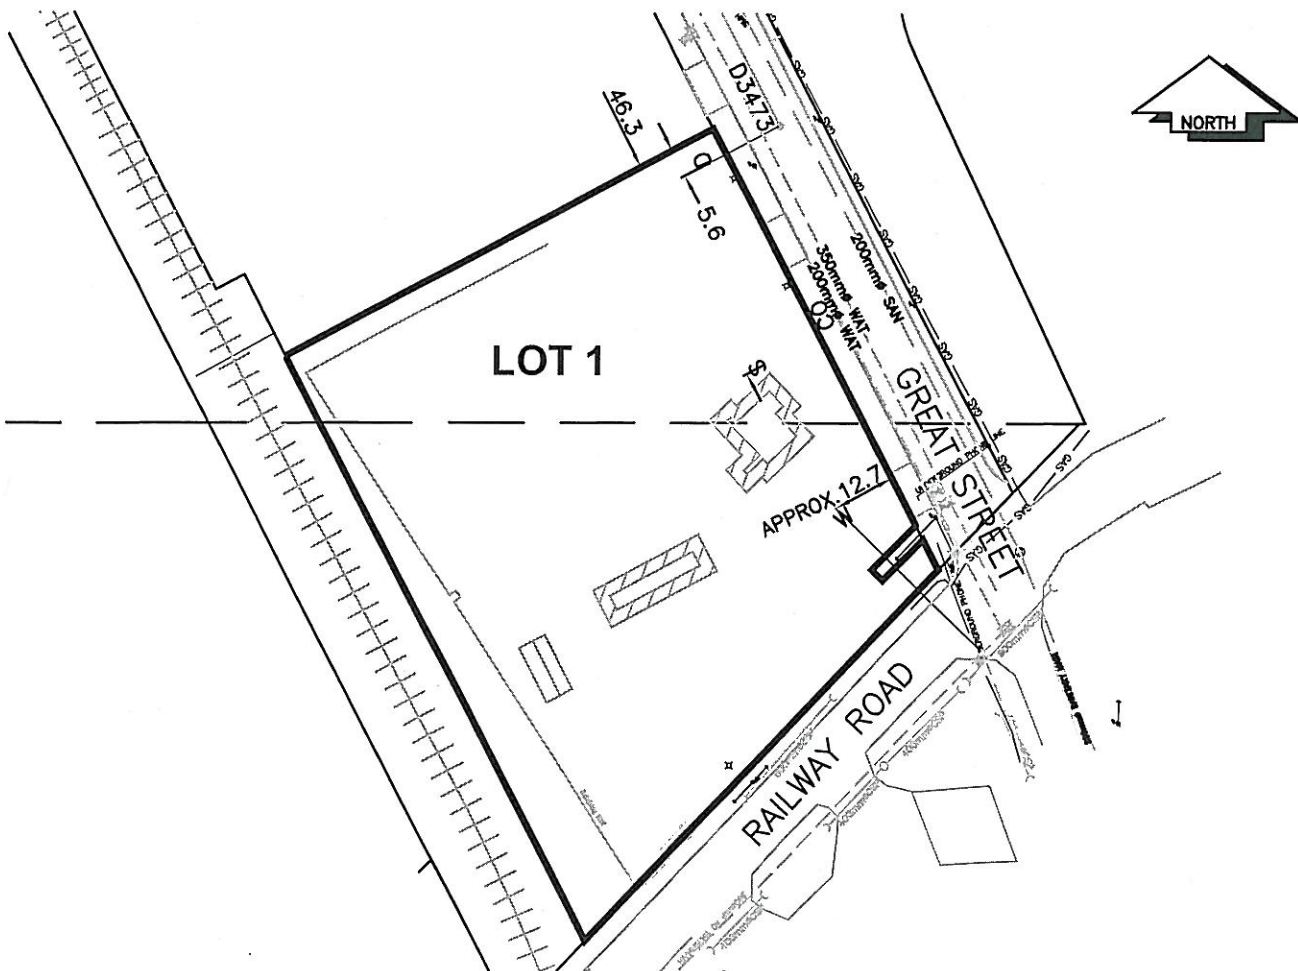

SANITARY, STORM & WATER SERVICE INVERTS	SANITARY	STORM	WATER
1. Distance from San. M.H. to connection point is toward San. M.H.		N/A	N/A
1a. Distance from Str. M.H. D3473 to connection point is 0m toward Str. M.H. D3473	N/A		N/A
2. Main Size at connection point is	200mmØ	600mmØ	200mmØ
3. Invert of main at conn. stub pt is	N/A	589.57	N/A
4. Invert at service end is	N/A	590.90	N/A
5. Cut at P/I in meters	N/A	2.19	N/A
6. Survey Date SEPTEMBER 20 06 Book Ref. 1126-13-03.3 by ALLNORTH			

SANITARY HISTORY:

SANITARY DATA TAKEN FROM EXISTING HISTORY SHEETS

WATER HISTORY:

STORM HISTORY:

SERVICE IS PROVIDED 3m INTO PROPERTY TO BE CONNECTED IN FUTURE BY OWNER
