



City of Prince George History Sheet

PID:	027662161
SD/MU:	
WO:	

Civic Address: 1002 Railway Rd
990 Industrial Way

Legal Description: Lot: 2 District Lot: 745 Plan: BCP38207 & DL 485


Service Type	Diameter (mm)	Material	Invert Elev at main (m)	Invert Elev at property line (m)	Invert Elev at service end (m)	Distance into property (m)	Installation Date
Sanitary	Unknown	AC	-	-	-	-	December 1977
Water (W1)	Unknown	Copper	-	-	-	-	December 1975
Water (W2)	Unknown	Copper	-	-	-	-	December 1975
Storm	N/A	N/A	-	-	-	-	

Service Connection Location	Sanitary (m)	Storm (m)
Sanitary service connected to San MH4143	-	
Distance from downstream Stm MH - towards upstream Stm MH -		

Power	Size	Communications	Size	Cable	Size	Gas	Size
BC Hydro	-	Telus	-	Shaw	-	FortisBC	-
Overhead Service		Overhead Service		Overhead Service			

Installed by:	Survey Date:	-
Comments: Water and Sanitary service locations confirmed June 2019		

NOT TO SCALE The information contained herein is for internal use only.
Not to be relied on unless confirmed by site inspection and/or investigation.

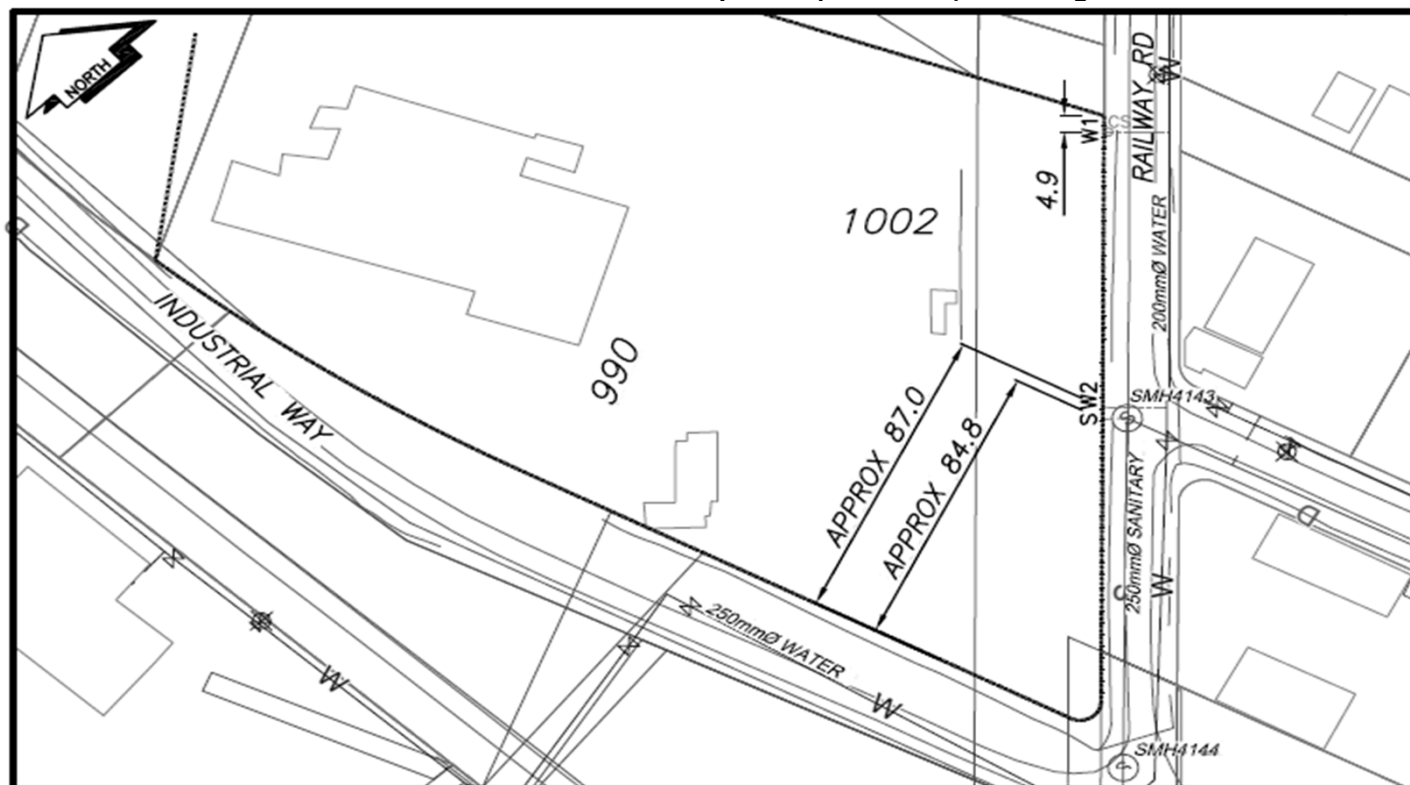

CS CURB STOP	--- WATER SERVICE	--- STORM SERVICE
CO CLEAN OUT	--- SANITARY SERVICE	--- GAS
WATER VALVE	--- FIRE HYDRANT	--- ENCUMBERANCE

NOT TO SCALE