

City of Prince George
HISTORY SHEET

PID: ~~027662926~~ 029353025

Scale: 1:2000

Legal: LOT 5 A D.L. 485 PLAN EPP41889 ~~PLAN BCP 38201~~

Address: 800 GREAT STREET

Sanitary Connection:# SIZE: 38mmØ MATERIAL: SDR-35 PVC INV. 588.44m CONNECTED - YES

Water Connection:# SIZE: 150mmØ MATERIAL: A.C. INV. N/A METER

Storm Connection:# SIZE: 375mmØ MATERIAL: PVC INV. 586.98m CONNECTED

Cash Receipt No's: WATER SANITARY STORM

CURB FROM PROPERTY LINE 5.0m PAVEMENT WIDTH 13.0m

B.C. HYDRO N/A U/G CONNECTION ✓

B.C. TELEPHONE N/A U/G CONNECTION ✓


B.C. GAS N/A

Information Sheets: REF. DWGS. L&M ENGINEERING LIMITED JOB NO. 1126-13-03.3 (001AB-402AB)

Comments: CS CURB STOP SDW WATER SERVICE SDH HYDRO SERVICE STORM SERVICE CABLE SERVICE TELECOMMUNICATIONS STORM MAIN SANITARY MAIN WATER MAIN GAS ELECTRICAL

THE INFORMATION CONTAINED HEREIN IS FOR INTERNAL USE ONLY.

NOT TO BE RELIED UPON UNLESS CONFIRMED BY THE SITE INSPECTION AND/OR INVESTIGATION

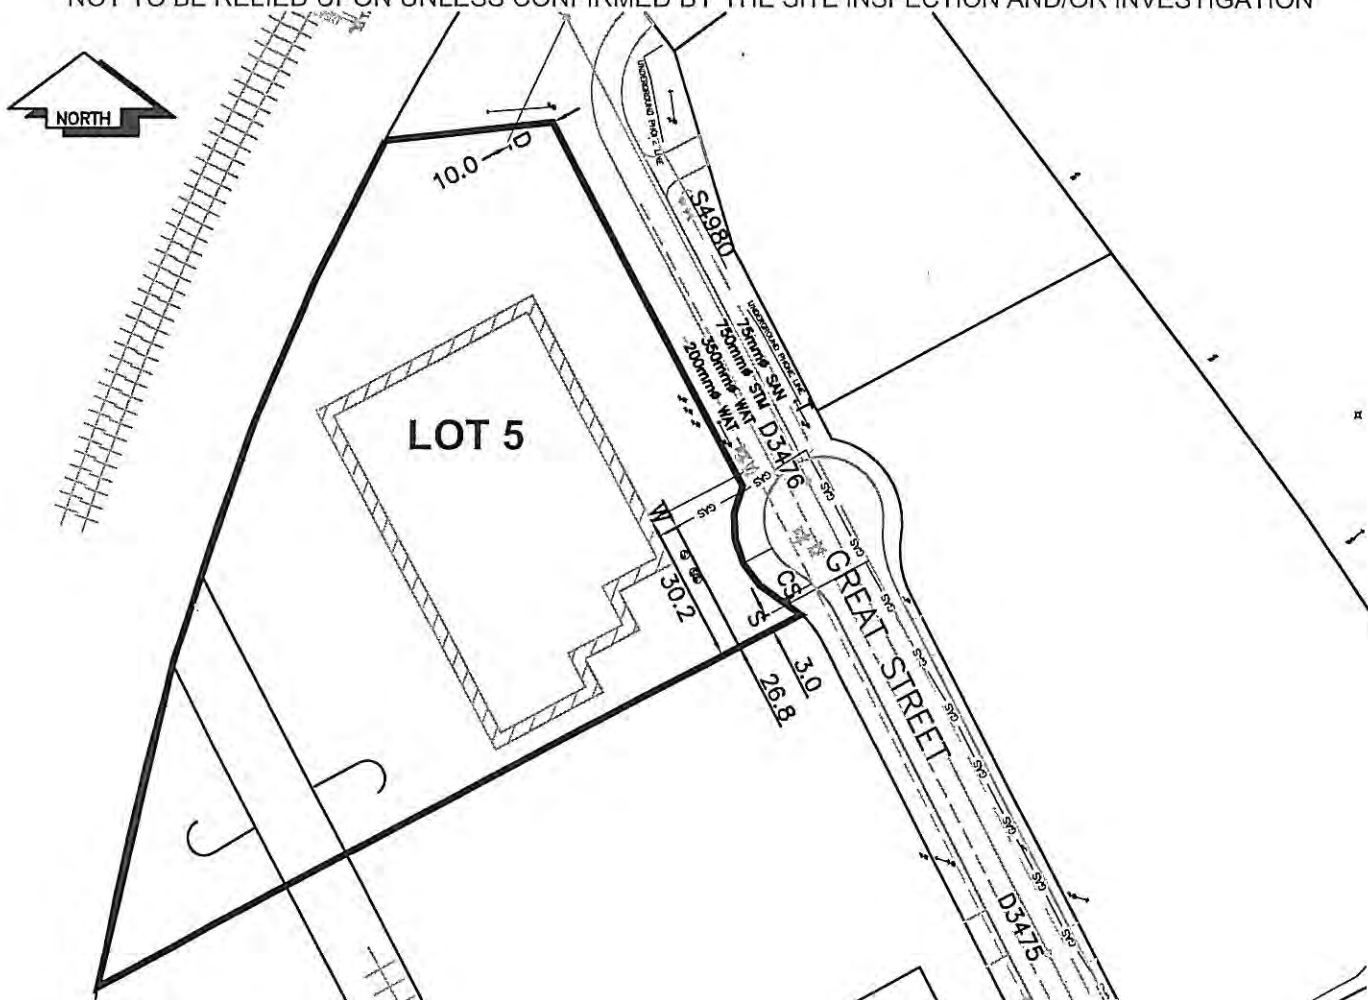

SANITARY, STORM & WATER SERVICE INVERTS	SANITARY	STORM	WATER
1. Distance from San. M.H. S-2 to connection point is 13.0m toward San. M.H. S-3		N/A	N/A
1a. Distance from Stm. M.H. D-4 to connection point is 0m toward Stm. M.H. D-4	N/A		N/A
2. Main Size at connection point is	75mmø	750mmø	200mmø
3. Invert of main at conn. stub pt is	588.44	586.85	N/A
4. Invert at service end is	588.44	586.98	N/A
5. Cut at P/I in meters	2.18	3.67	N/A
6. Survey Date SEPTEMBER 20 06 Book Ref. 1126-13-03.3 by ALLNORTH			

SANITARY HISTORY:

SERVICE IS PROVIDED 3m INTO PROPERTY TO BE CONNECTED IN FUTURE BY OWNER

WATER HISTORY:

STORM HISTORY:

SERVICE IS PROVIDED 3m INTO PROPERTY TO BE CONNECTED IN FUTURE BY OWNER
