

City of Prince George
HISTORY SHEET

PID: 027662934

Scale: - 1:1000

Legal: LOT 6

D.L. 485

PLAN BCP38207

Address: 881 GREAT STREET

Sanitary Connection:# SIZE: 38mmØ MATERIAL: SDR-35 PVC INV. 587.38m CONNECTED -

Water Connection:# SIZE: 350mmØ MATERIAL: DI INV. 585.34m METER

Storm Connection:# SIZE: 375mmØ MATERIAL: PVC INV. 586.38m CONNECTED

Cash Receipt No's: WATER SANITARY STORM

CURB FROM PROPERTY LINE

PAVEMENT WIDTH

B.C. HYDRO N/A

U/G CONNECTION



B.C. TELEPHONE N/A

U/G CONNECTION




B.C. GAS N/A

Information Sheets: REF. DWGS. L&M ENGINEERING LIMITED JOB NO. 1126-13-03.3 (001AB-402AB)

Comments: CS CURB STOP SDW WATER SERVICE FCH HYDRO SERVICE STORM MAIN GAS
CO CLEAN OUT STORM SERVICE CABLE SERVICE SANITARY MAIN
SANITARY SERVICE TELECOMMUNICATIONS WATER MAIN ELECTRICAL

THE INFORMATION CONTAINED HEREIN IS FOR INTERNAL USE ONLY.

NOT TO BE RELIED UPON UNLESS CONFIRMED BY THE SITE INSPECTION AND/OR INVESTIGATION

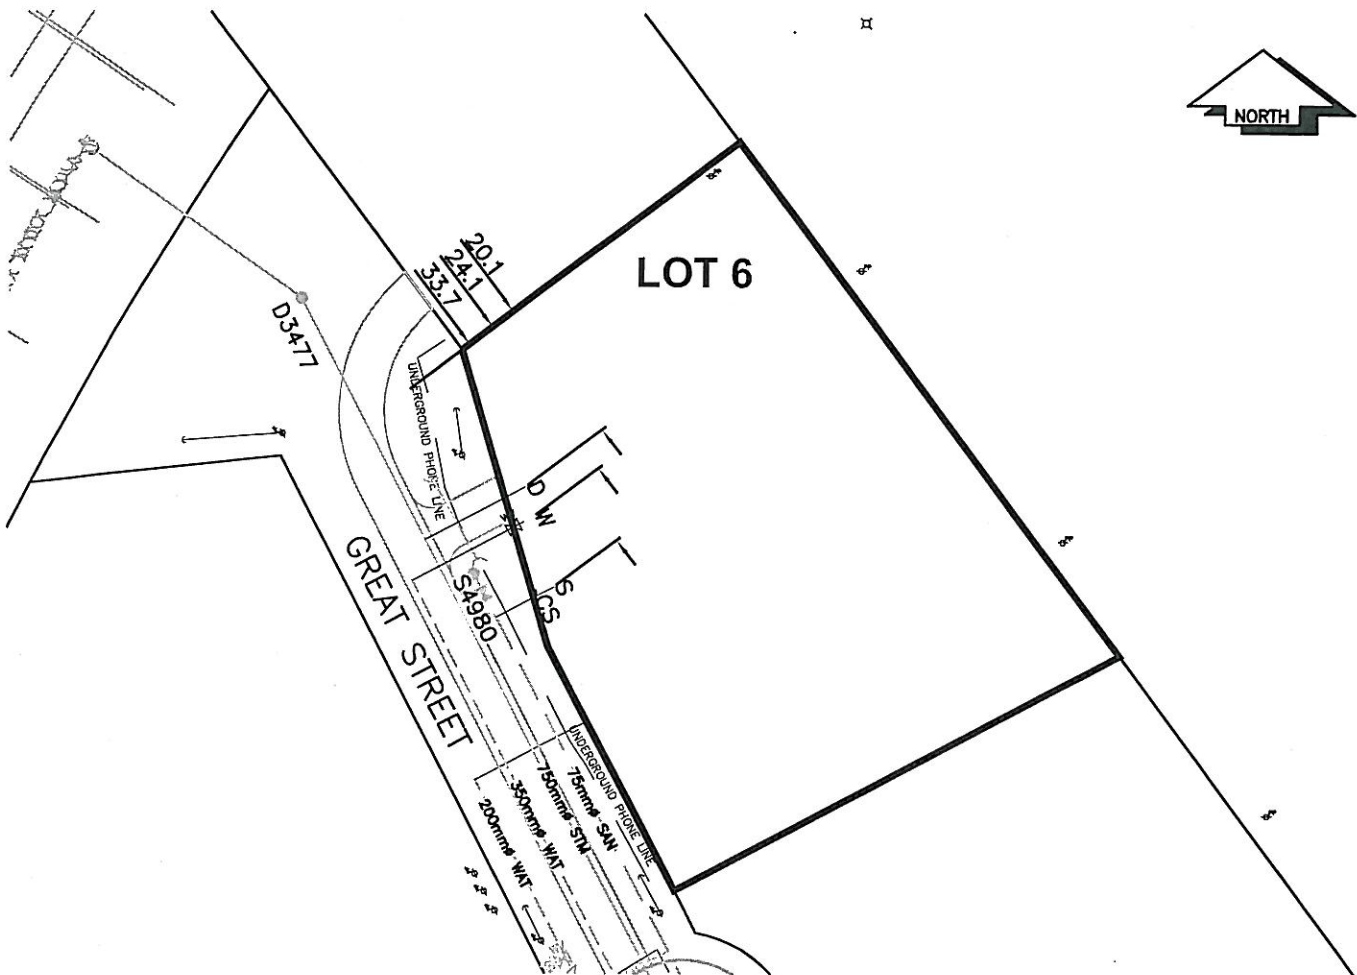

SANITARY, STORM & WATER SERVICE INVERTS	SANITARY	STORM	WATER
1. Distance from San. M.H. to connection point is toward San. M.H.		N/A	N/A
1a. Distance from Stm. M.H. D-5 to connection point is 36.0m toward Stm. M.H. D-4	N/A		N/A
2. Main Size at connection point is	75mmø	750mmø	200mmø
3. Invert of main at conn. stub pt is	587.63	586.28	585.49
4. Invert at service end is	587.58	586.38	585.34
5. Cut at P/I in meters	2.85	4.05	5.09
6. Survey Date SEPTEMBER 20 06 Book Ref. 1126-13-03.3 by ALLNORTH			

SANITARY HISTORY:

SERVICE IS PROVIDED 3m INTO PROPERTY TO BE CONNECTED IN FUTURE BY OWNER

WATER HISTORY:

SERVICE IS PROVIDED 3m INTO PROPERTY TO BE CONNECTED IN FUTURE BY OWNER

STORM HISTORY:

SERVICE IS PROVIDED 3m INTO PROPERTY TO BE CONNECTED IN FUTURE BY OWNER