

City of Prince George
HISTORY SHEET

PID: 027662951

Scale: - 1:1000

Legal: LOT 8

D.L. 485

PLAN BCP 38207

Address: 931 GREAT STREET

Sanitary Connection:# SIZE: 38mmØ MATERIAL: P.E. INV. N/A CONNECTED -

Water Connection:# SIZE: 150mmØ MATERIAL: A.C. INV. m METER

Storm Connection:# SIZE: 300mmØ MATERIAL: PVC INV. m CONNECTED-

Cash Receipt No's: WATER SANITARY STORM

CURB FROM PROPERTY LINE 2.0m PAVEMENT WIDTH 13.0m

B.C. HYDRO N/A U/G CONNECTION ✓


B.C. TELEPHONE N/A U/G CONNECTION ✓

B.C. GAS N/A

Information Sheets: REF. DWGS. L&M ENGINEERING LIMITED JOB NO. 1126-13-03.3 (001AB-402AB)

Comments: CS CURB STOP CO CLEAN OUT SD WATER SERVICE STORM SERVICE SANITARY SERVICE HYDRO SERVICE CABLE SERVICE TELECOMMUNICATIONS STORM MAIN SANITARY MAIN WATER MAIN GAS ELECTRICAL

THE INFORMATION CONTAINED HEREIN IS FOR INTERNAL USE ONLY.
NOT TO BE RELIED UPON UNLESS CONFIRMED BY THE SITE INSPECTION AND/OR INVESTIGATION

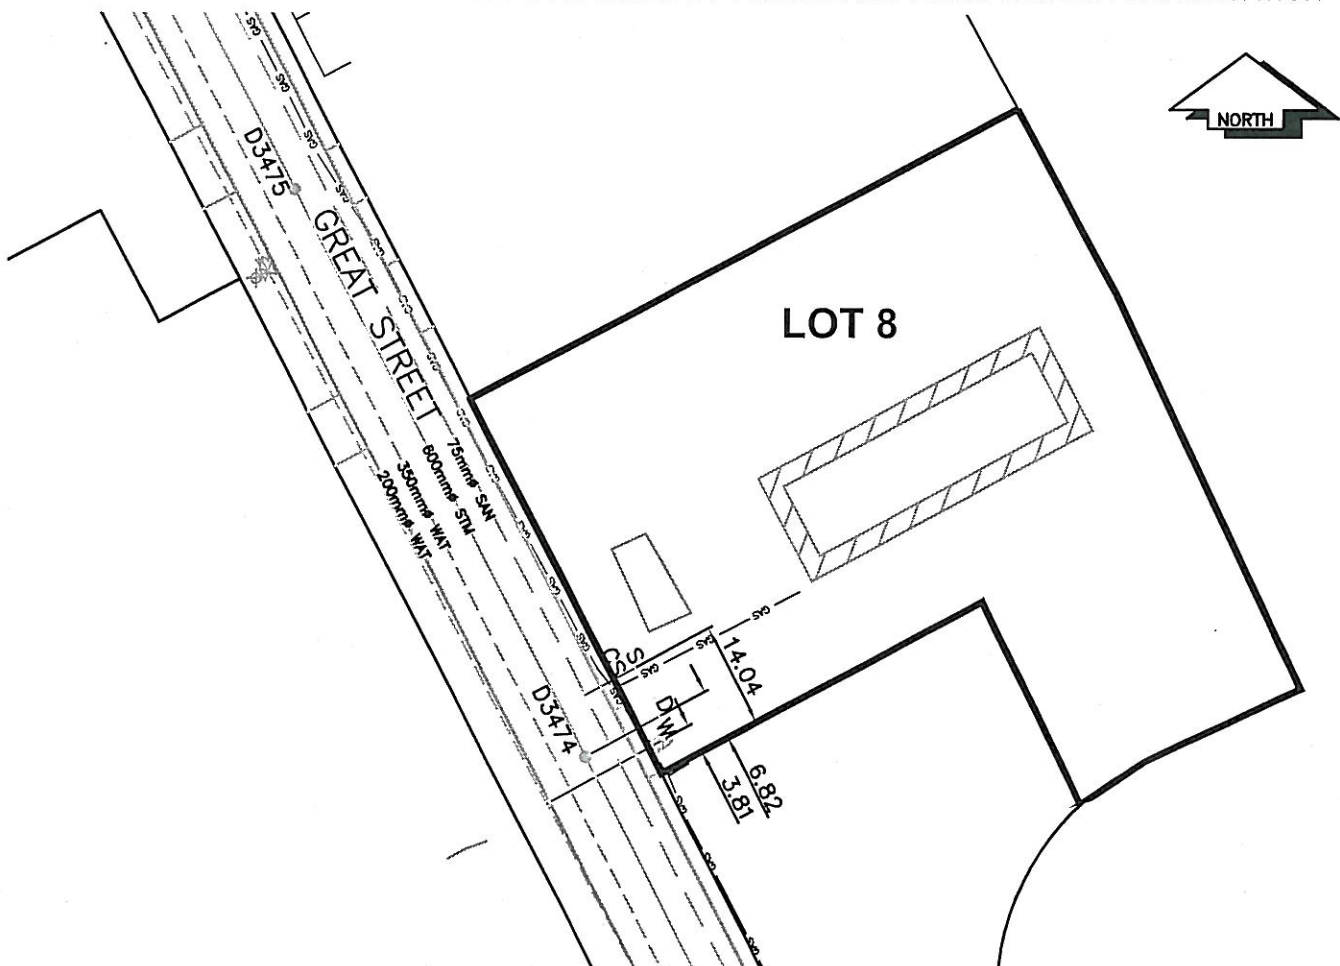

SANITARY, STORM & WATER SERVICE INVERTS	SANITARY	WATER	STORM
1. Distance from San. M.H. JH53A toward San. M.H. S4980 to lot service connection point is:	294.76m	m	m
1a. Distance from Stm. M.H. D3474 toward Stm. M.H. D3475 to lot service connection point is:	m	m	84.71m
2. Main Size at connection point is	75mmØ	200mmØ	600mmØ
3. Invert of main at conn. stub pt is	590.38m	587.93m	588.48m
4. Invert at service end is	589.70m	588.28m	588.72m
5. Cut at P/I in meters	3.5m	3.1m	3.5m
6. Survey Date: SEPT 2006 Book Ref.: 1126-13-3.3 By: ALLNORTH			

SANITARY HISTORY:

SERVICE IS PROVIDED 3m INTO PROPERTY TO BE CONNECTED BY FUTURE OWNER

WATER HISTORY:

STORM HISTORY:

SERVICE IS PROVIDED 3m INTO PROPERTY TO BE CONNECTED BY FUTURE OWNER