



# City of Prince George History Sheet

|      |           |
|------|-----------|
| PID: | 027676820 |
| SD:  | 100278    |
| WO:  |           |

Civic Address: 4655 Shamrock Rd

Legal Description: Lot: 1 District Lot: 4046 Plan: BCP38502


| Service Type | Diameter (mm) | Material | Invert Elev at main (m) | Invert Elev at property line (m) | Invert Elev at service end (m) | Distance into property (m) | Installation Date |
|--------------|---------------|----------|-------------------------|----------------------------------|--------------------------------|----------------------------|-------------------|
| Sanitary     | 100mm         | PVC      | -                       | -                                | -                              | -                          | December 2008     |
| Water        | N/A           | N/A      | -                       | -                                | -                              | -                          |                   |
| Storm        | N/A           | N/A      | -                       | -                                | -                              | -                          |                   |

| Service Connection Location     |      |                         |      | Sanitary (m) | Storm (m) |
|---------------------------------|------|-------------------------|------|--------------|-----------|
| Distance from downstream San MH | 1311 | towards upstream San MH | 1309 | 45.90        |           |
| Distance from downstream Stm MH | -    | towards upstream Stm MH | -    |              |           |

| Power            | Size | Communications   | Size | Cable            | Size | Gas      | Size |
|------------------|------|------------------|------|------------------|------|----------|------|
| BC Hydro         | -    | Telus            | -    | Shaw             | -    | FortisBC | -    |
| Overhead Service |      | Overhead Service |      | Overhead Service |      |          |      |

|               |              |   |
|---------------|--------------|---|
| Installed by: | Survey Date: | - |
| Comments:     |              |   |
|               |              |   |
|               |              |   |

**NOT TO SCALE** The information contained herein is for internal use only.  
Not to be relied on unless confirmed by site inspection and/or investigation.

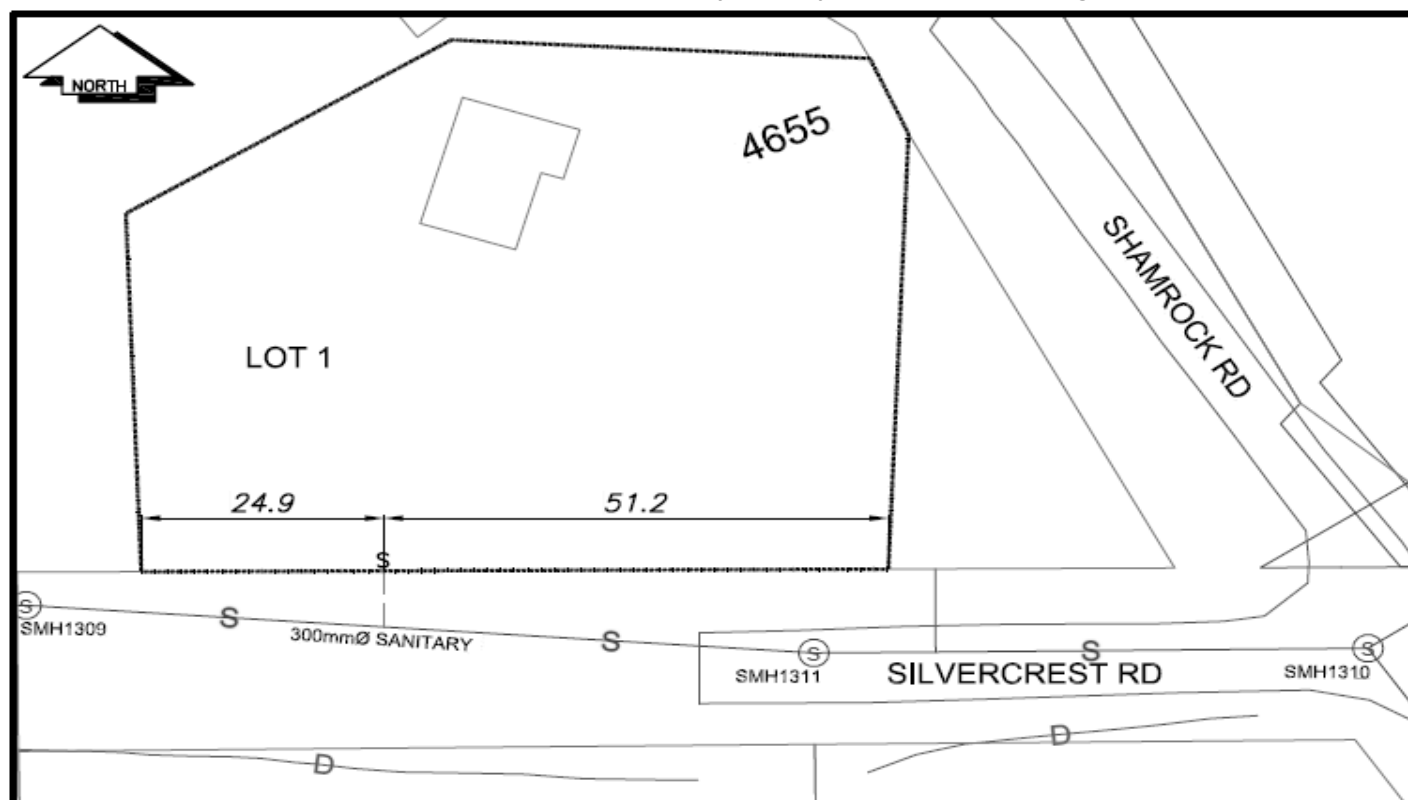

|                           |                            |                       |
|---------------------------|----------------------------|-----------------------|
| CS <sup>o</sup> CURB STOP | —=— WATER SERVICE          | —o— STORM SERVICE     |
| CO <sup>o</sup> CLEAN OUT | - - - - - SANITARY SERVICE | —G— GAS               |
| ⊗ WATER VALVE             | ⊗ FIRE HYDRANT             | - - - - - ENCUMBRANCE |

**NOT TO SCALE**