


Lot Servicing

2975 CHARELLA DR

PID: 027681301

Lot: A, Plan: BCP38587, DL: 9261

| SERVICE | SIZE | MATERIAL | INSTALLED DATE | LOCATION | DETAILS |
|----------|-------|----------|----------------|--|-----------------------|
| WATER | 20MM | CU | | FROM NW CORNER OF BLDG 6.4M N; 8M W | THAW WIRE Y |
| SANITARY | 100MM | UNKNOWN | 01-Jan-1980 | 8.3M E OF NW COR PL | CONNECTION # 14079 |

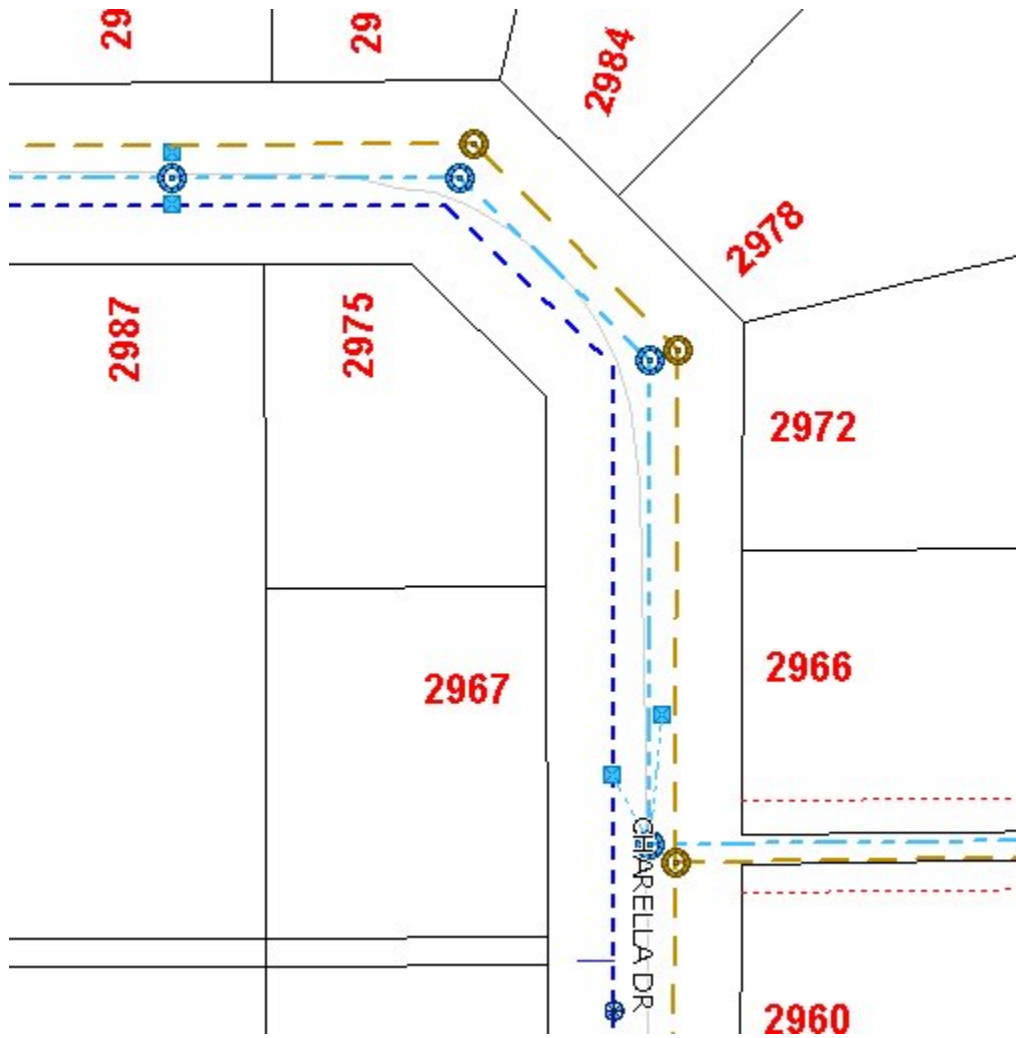

Accuracy not guaranteed unless confirmed by site inspection and/or investigation.
Connection location between main and property line only.

City of Prince George
HISTORY SHEET

PID 027681301

SHEET NUMBER N^o 4691

Roll Number ~~011201851~~

Legal: LOT'S ~~38~~^A BLOCK D.L. 9261 PLAN ~~11361~~^{BCP38587}

Address: 2975 CHARELLA DR.

Sanitary Connection: # 14079 SIZE 100mm MATERIAL INV. CONNECTED

Water Connection # SIZE 3/4" MATERIAL Copper METER CONNECTED

Storm Connection: # SIZE MATERIAL INV. CONNECTED

Cash Receipt No's: WATER SANITARY STORM

CURB FROM PROPERTY LINE PAVEMENT WIDTH

B.C. HYDRO UNDERGROUND CONNECTION

B.C. TELEPHONE UNDERGROUND CONNECTION

INLAND GAS

Information Sheets: THE INFORMATION CONTAINED HEREIN IS FOR INTERNAL
Comments: USE ONLY. NOT TO BE RELIED UPON UNLESS CONFIRMED
BY SITE INSPECTION AND/OR INVESTIGATION.

