
Lot Servicing

245 ALWARD ST PID 027694674

Lot: PCL A, Block: 52, Plan: 1268, DL: 343 (BB1020553)

SERVICE	SIZE	MATERIAL	INSTALLED DATE	LOCATION	DETAILS
WATER	UNKNOWN	UNKNOWN		FR SE CORNER BLDG 9.4M E 5.4MS	
SANITARY	100MM	AC		CLEANOUT 8.199M S OF N PL	CLEANOUT Y

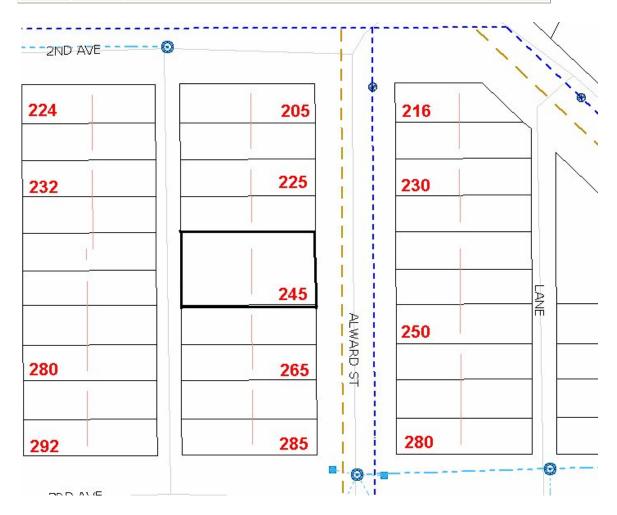

Accuracy not guaranteed unless confirmed by site inspection and/or investigation. Connection location between main and property line only.