


Lot Servicing

721 CARNEY ST

PID: 027694780

Lot: A, Plan: BCP38474, DL: 937

SERVICE	SIZE	MATERIAL	INSTALLED DATE	LOCATION	DETAILS
WATER	20MM	CU	04-Sep-1996	12.308M S OF N PL ; SP FR NE COR BLD 7.9M E ?M S	CASH RECEIPT NUMBER 18384
SANITARY	100MM	PVC	04-Sep-1996	4.26M N OF SE COR PL	CLEANOUT FR N COR BLD 7.2M E 3.9M S

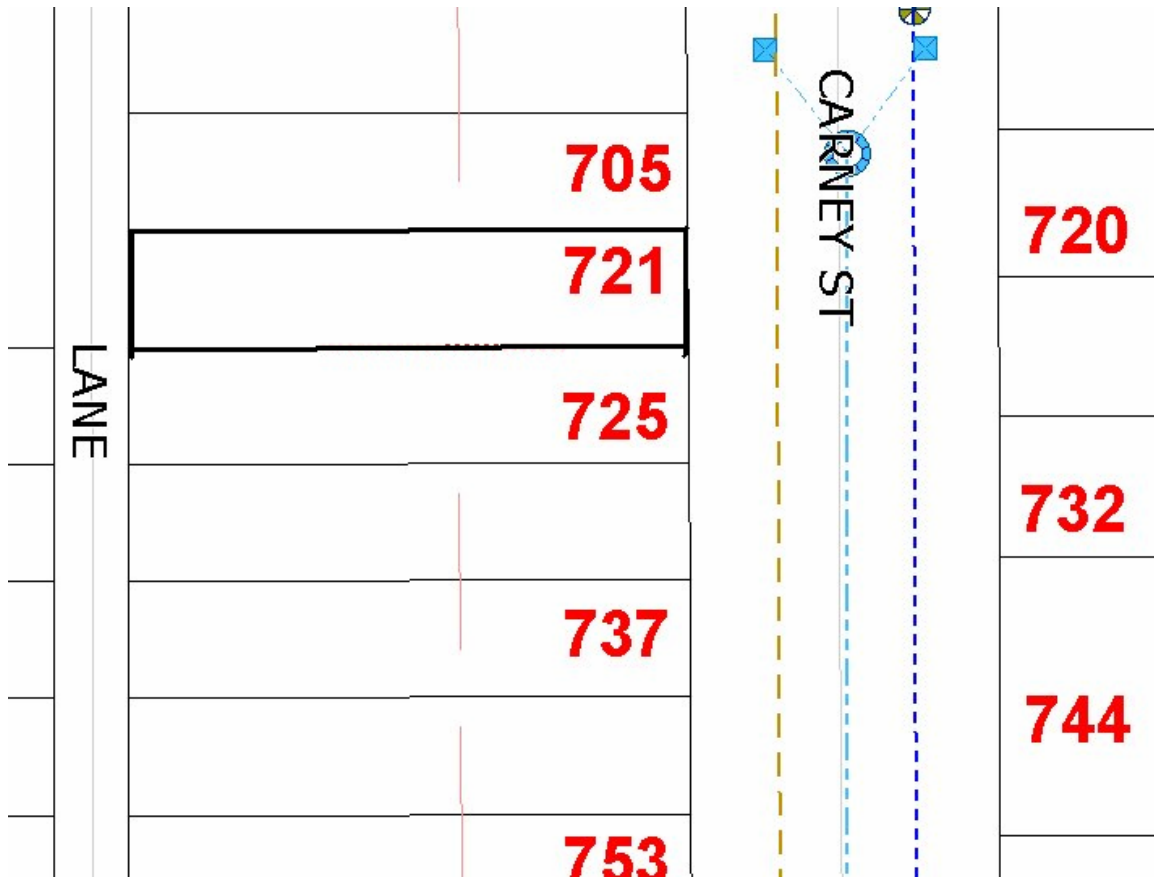

Accuracy not guaranteed unless confirmed by site inspection and/or investigation.
Connection location between main and property line only.