


## Lot Servicing

725 CARNEY ST

PID: 027694798

**Lot: B, Plan: BCP38474, DL: 937**

SERVICE	SIZE	MATERIAL	INSTALLED DATE	LOCATION	DETAILS
WATER	20MM	CU	04-Sep-1996	12.308M S OF N PL ; SP FR SE COR BLD 9M E 1M S	
SANITARY	100MM	PVC	04-Sep-1996	4.26M N OF SE COR PL	CLEANOUT FR S COR BLD 6M E 0.2M S

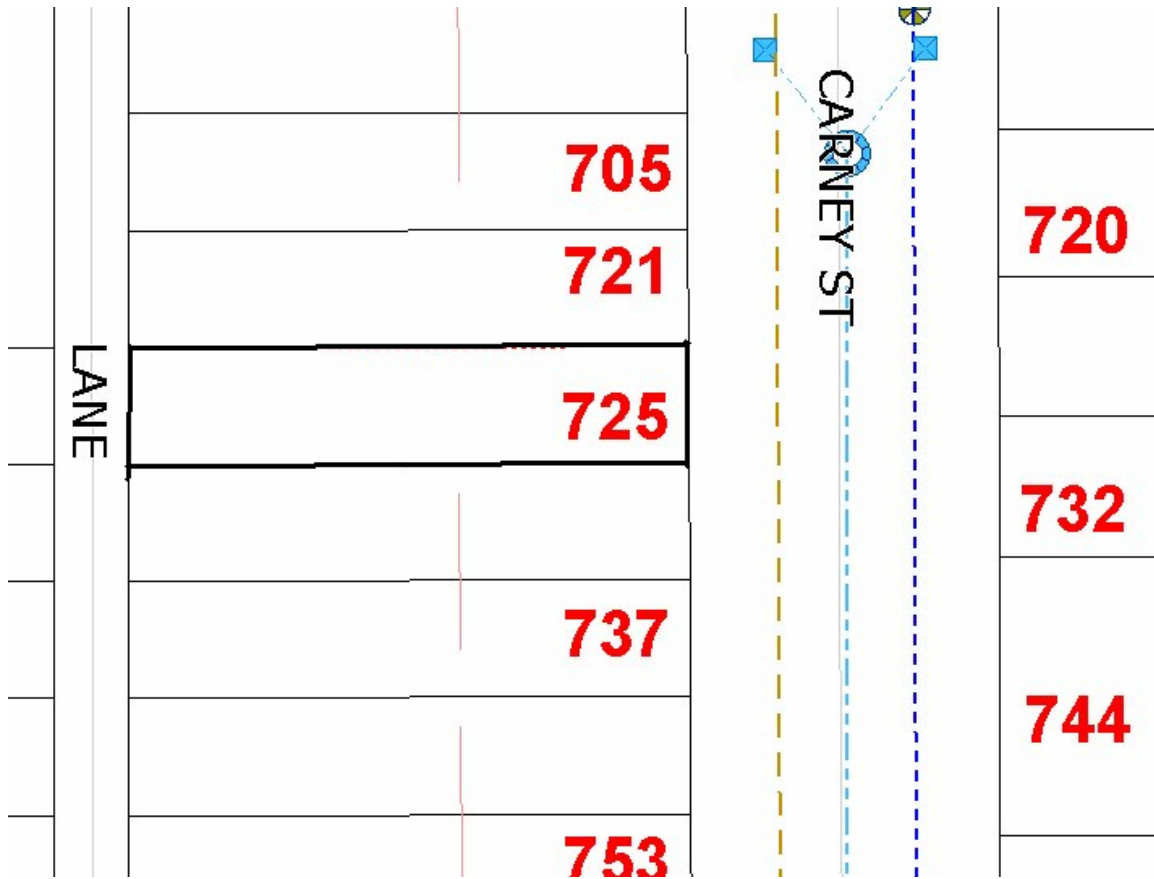

Accuracy not guaranteed unless confirmed by site inspection and/or investigation.  
Connection location between main and property line only.