


## Lot Servicing

4159 ESTAVILLA DR

PID: 027696073

Lot: 2, Plan: BCP38834, DL: 2433

| SERVICE  | SIZE  | MATERIAL | INSTALLED DATE | LOCATION                                  | DETAILS                       |
|----------|-------|----------|----------------|---|-------------------------------|
| WATER    | 20MM  | CU       | 11-Sep-2008    | 4.2M W OF E PL                            | CASH RECEIPT<br>NUMBER 100900 |
| SANITARY | 100MM | PVC      | 11-Sep-2008    | 4.0M W OF E PL SERVICE RUNS<br>TO MANHOLE | RECEIPT # 100900              |
|          |       |          |                |   |                               |

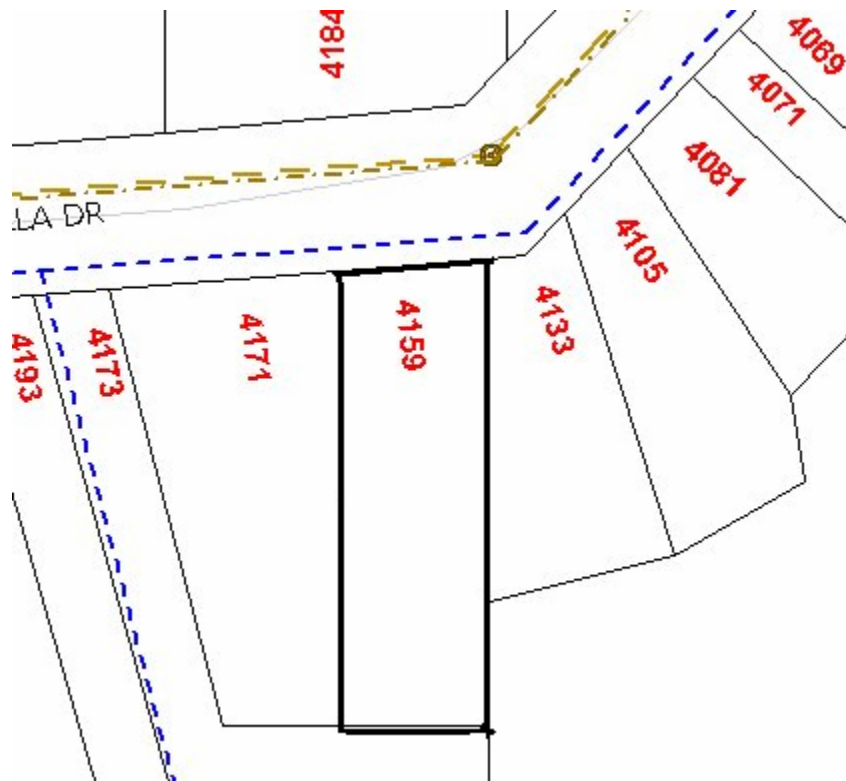

Accuracy not guaranteed unless confirmed by site inspection and/or investigation.  
Connection location between main and property line only.