

City of Prince George

HISTORY SHEET

PID: 027720756

Scale: 1:3000

Legal: LOT 3

D.L.: 745

PLAN: BCP38932

Address: 1716 Willow Cale Road

Sanitary Connection:#	SIZE: 200mmØ	MATERIAL: PVC	INV. 585.14m	CONNECTED Y N
-----------------------	--------------	---------------	--------------	---------------

Water Connection:#	SIZE: 50mmØ	MATERIAL: Copper	INV. 584.50m	METER Y N
--------------------	-------------	------------------	--------------	-----------

Storm Connection:#	SIZE -	MATERIAL -	INV. -	CONNECTED -
--------------------	--------	------------	--------	-------------

Cash Receipt No's:	WATER	SANITARY	STORM
--------------------	-------	----------	-------

CURB FROM PROPERTY LINE	n/a	PAVEMENT WIDTH	12m
-------------------------	-----	----------------	-----

B.C. HYDRO	OH	U/G CONNECTION	✓
------------	----	----------------	---

B.C. TELEPHONE	OH	U/G CONNECTION	✓
----------------	----	----------------	---


B.C. GAS	-		
----------	---	--	--

Information Sheets: -

Comments:	CS CURB STOP CO CLEAN OUT	SDW WATER SERVICE STORM SERVICE SANITARY SERVICE	CH HYDRO SERVICE CABLE SERVICE TELECOMMUNICATIONS	--- GAS --- ELECTRICAL
-----------	------------------------------	---	--	---------------------------

THE INFORMATION CONTAINED HEREIN IS FOR INTERNAL USE ONLY.

NOT TO BE RELIED UPON UNLESS CONFIRMED BY THE SITE INSPECTION AND/OR INVESTIGATION

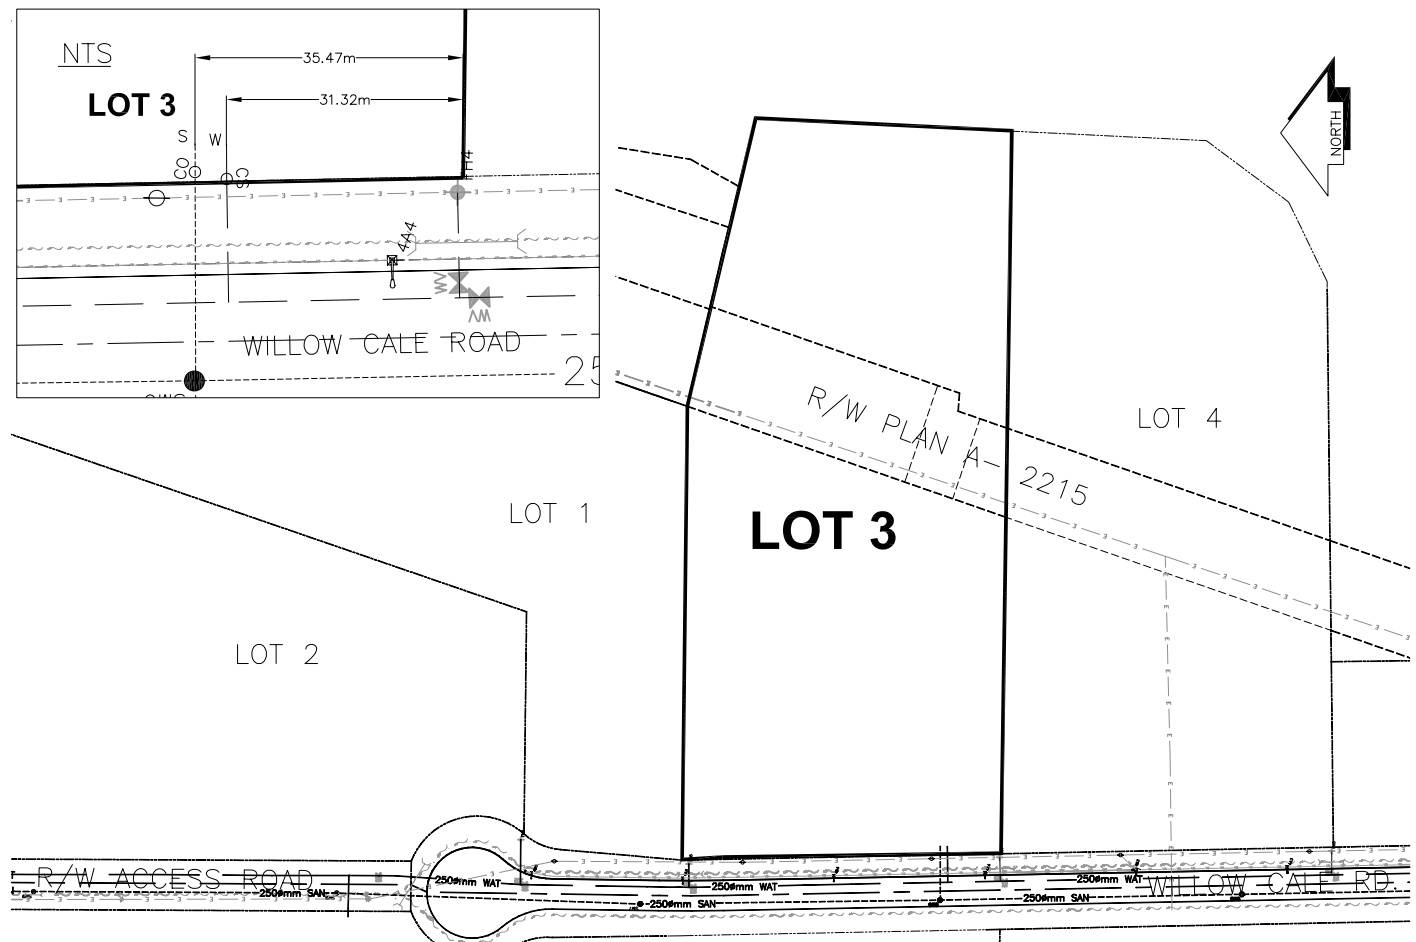

[illegible]

SANITARY HISTORY:

[illegible]

WATER HISTORY:

[illegible]

STORM HISTORY:

[illegible]