

City of Prince George

HISTORY SHEET

PID: 027720772

Scale: 1:500

Legal: LOT 5

D.L.: 745

PLAN: BCP38932

Address: 3228 Willow Cale Road

Sanitary Connection:# SIZE: 200mmØ MATERIAL: PVC INV. 583.46m CONNECTED Y N

Water Connection:# SIZE: 50mmØ MATERIAL: Copper INV. 584.82m METER Y N

Storm Connection:# SIZE: - MATERIAL: - INV. - CONNECTED -

Cash Receipt No's: WATER SANITARY STORM

CURB FROM PROPERTY LINE n/a PAVEMENT WIDTH 12m

B.C. HYDRO OH U/G CONNECTION ✓


B.C. TELEPHONE OH U/G CONNECTION ✓

B.C. GAS -

Information Sheets: -

Comments: CS CURB STOP CO CLEAN OUT SOW WATER SERVICE STORM SERVICE SANITARY SERVICE TCH HYDRO SERVICE CABLE SERVICE TELECOMMUNICATIONS GAS ELECTRICAL

THE INFORMATION CONTAINED HEREIN IS FOR INTERNAL USE ONLY.
NOT TO BE RELIED UPON UNLESS CONFIRMED BY THE SITE INSPECTION AND/OR INVESTIGATION

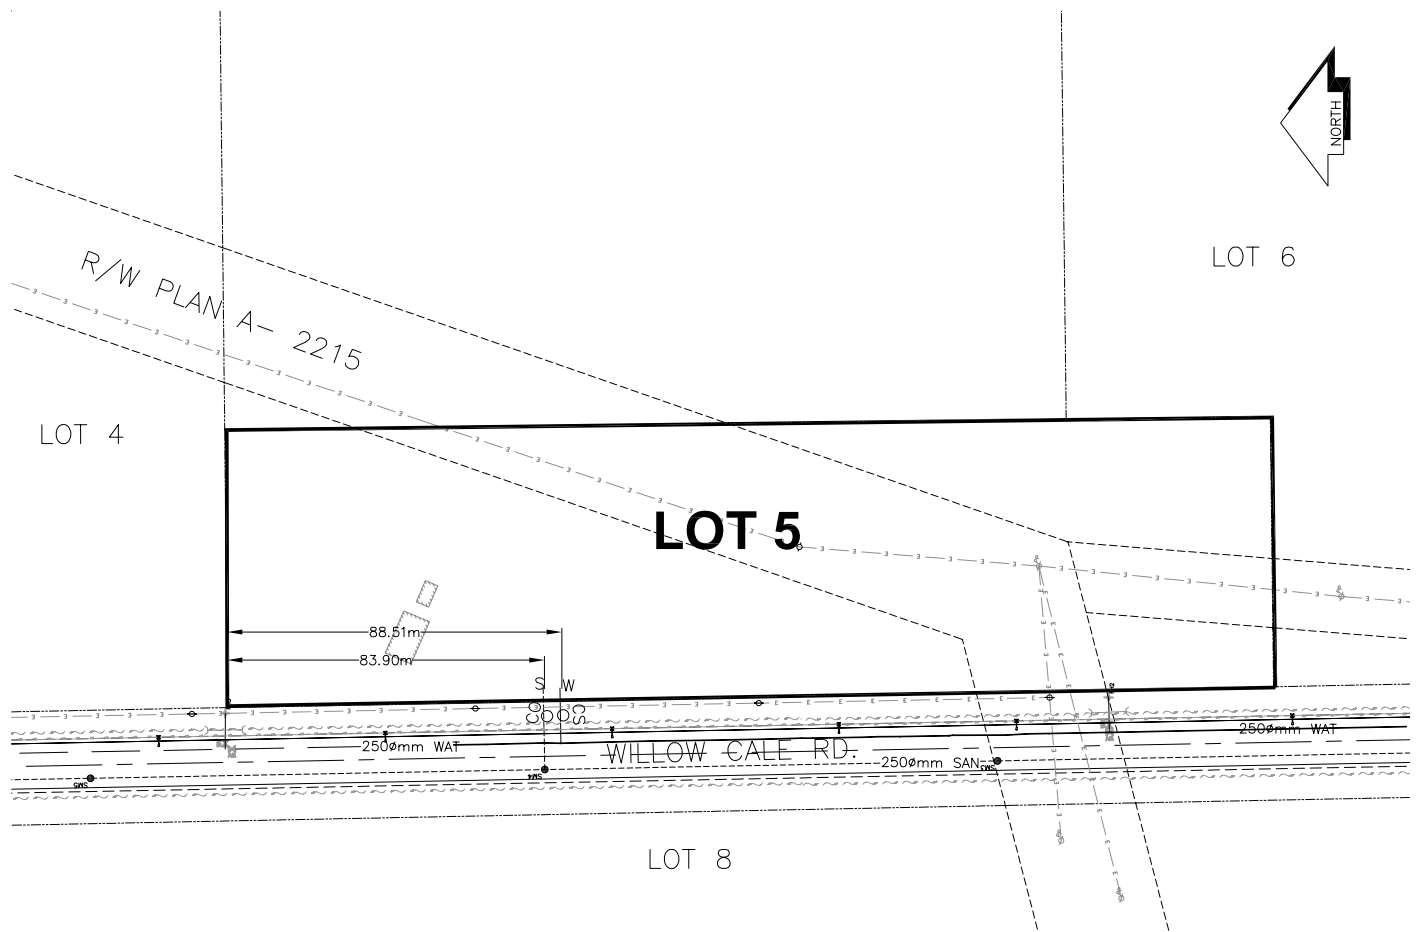

STORM

SANITARY HISTORY:

[illegible][illegible]