

# City of Prince George

## HISTORY SHEET

PID: 027721752

Scale: 1:2500

Legal: LOT 7

D.L.: 745 & 747

PLAN: BCP38932

Address: 4066 Willow Cale Road

Sanitary Connection:# SIZE: 200mmØ MATERIAL: PVC INV. 584.41m CONNECTED Y N

Water Connection:# SIZE: 50mmØ MATERIAL: Copper INV. 582.12m METER Y N

Storm Connection:# SIZE: - MATERIAL: - INV. - CONNECTED -

Cash Receipt No's: WATER SANITARY STORM

CURB FROM PROPERTY LINE n/a PAVEMENT WIDTH 12 m

B.C. HYDRO OH U/G CONNECTION ✓

B.C. TELEPHONE OH U/G CONNECTION ✓


B.C. GAS -

Information Sheets: -

Comments: CS CURB STOP CO CLEAN OUT SDW WATER SERVICE STORM SERVICE SANITARY SERVICE TCH HYDRO SERVICE CABLE SERVICE TELECOMMUNICATIONS GAS ELECTRICAL

THE INFORMATION CONTAINED HEREIN IS FOR INTERNAL USE ONLY.

NOT TO BE RELIED UPON UNLESS CONFIRMED BY THE SITE INSPECTION AND/OR INVESTIGATION

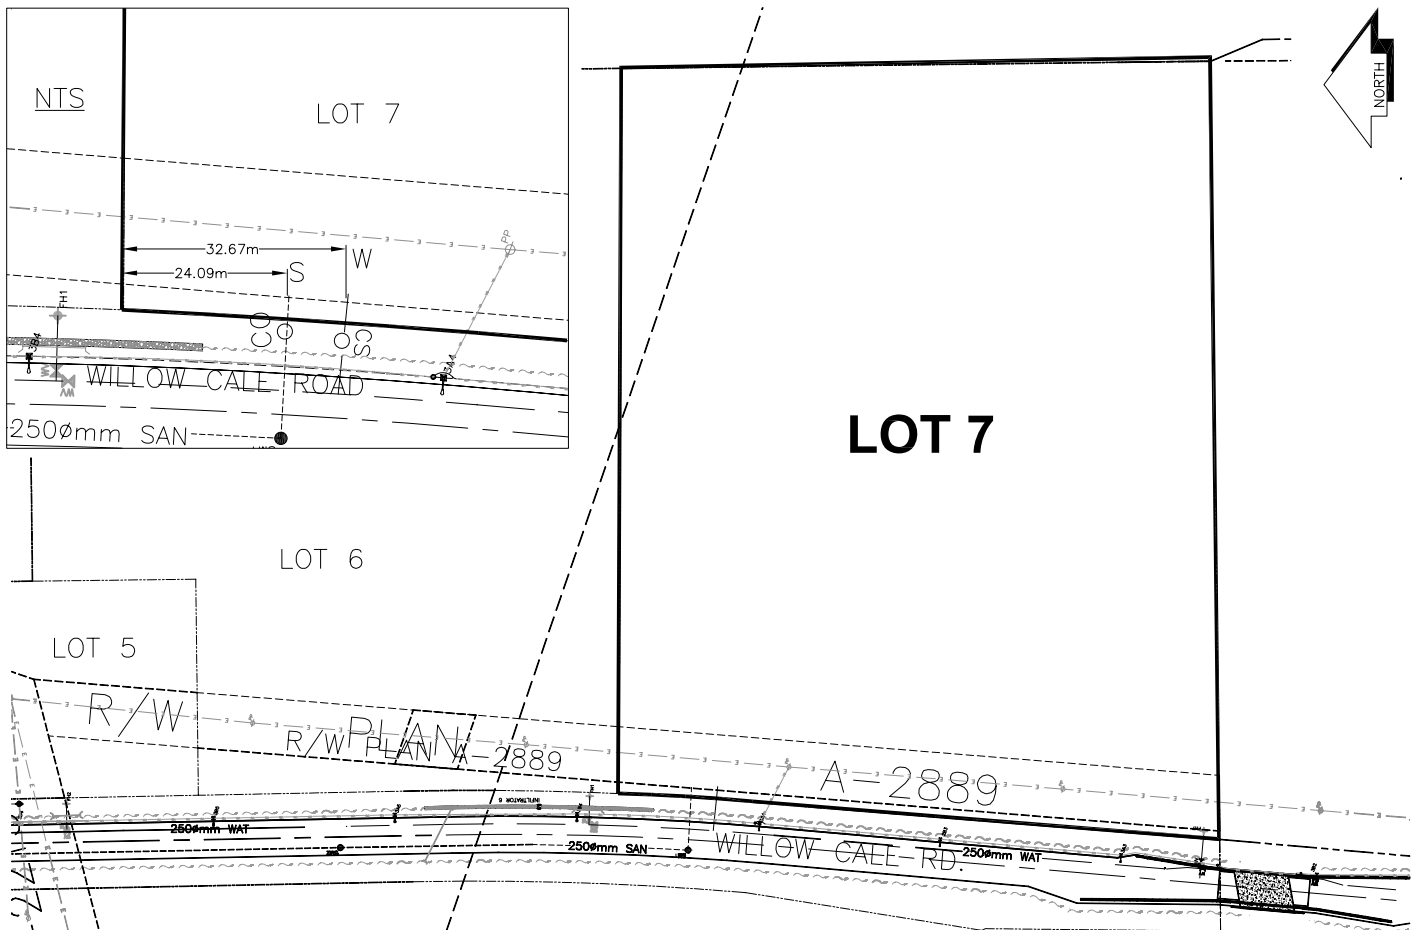

SANITARY, STORM & WATER SERVICE INVERTS	SANITARY	WATER	STORM
1. Distance from San. M.H. <u>  #2  </u> toward San. M.H. <u>  #1  </u> to lot service connection point is:	115.0m	123.0m	n/a
1a.Distance from Stm. M.H. <u>    </u> toward Stm. M.H. <u>    </u> to lot service connection point is:	n/a	n/a	n/a
2. Main Size at connection point is	250mmØ	250mmØ	n/a
3. Invert of main at conn. stub point is	583.96m	582.21m	n/a
4. Invert at service end is	584.34m	582.09m	n/a
5. Cut at property line in meters	1.7m	1.9m	n/a
6. Survey Date:08/01/29    Book Ref.: -                      By: AllNorth			

SANITARY HISTORY:

---

---

WATER HISTORY:

---

---

STORM HISTORY:

---

---

