

City of Prince George

HISTORY SHEET

PID: 027721809

Scale: 1:5000

Legal: LOT 8

D.L.: 745 and 747

PLAN: BCP38932

Address: 3225 Willow Cale Road

Sanitary Connection:#	SIZE: 200mmØ	MATERIAL: PVC	INV. 582.97m	CONNECTED Y N
-----------------------	--------------	---------------	--------------	---------------

Water Connection:#	SIZE: 50mmØ	MATERIAL: Copper	INV. 584.86m	METER Y N
--------------------	-------------	------------------	--------------	-----------

Storm Connection:#	SIZE -	MATERIAL -	INV. -	CONNECTED -
--------------------	--------	------------	--------	-------------

Cash Receipt No's:	WATER	SANITARY	STORM
--------------------	-------	----------	-------

CURB FROM PROPERTY LINE	n/a	PAVEMENT WIDTH	12m
-------------------------	-----	----------------	-----

B.C. HYDRO	OH	U/G CONNECTION	✓
------------	----	----------------	---


B.C. TELEPHONE	OH	U/G CONNECTION	✓
----------------	----	----------------	---

B.C. GAS	-		
----------	---	--	--

Information Sheets: -

Comments:	CS CURB STOP CO CLEAN OUT	SDW WATER SERVICE STORM SERVICE SANITARY SERVICE	CH HYDRO SERVICE CABLE SERVICE TELECOMMUNICATIONS	GAS ELECTRICAL
-----------	------------------------------	--	---	-------------------

THE INFORMATION CONTAINED HEREIN IS FOR INTERNAL USE ONLY.
NOT TO BE RELIED UPON UNLESS CONFIRMED BY THE SITE INSPECTION AND/OR INVESTIGATION

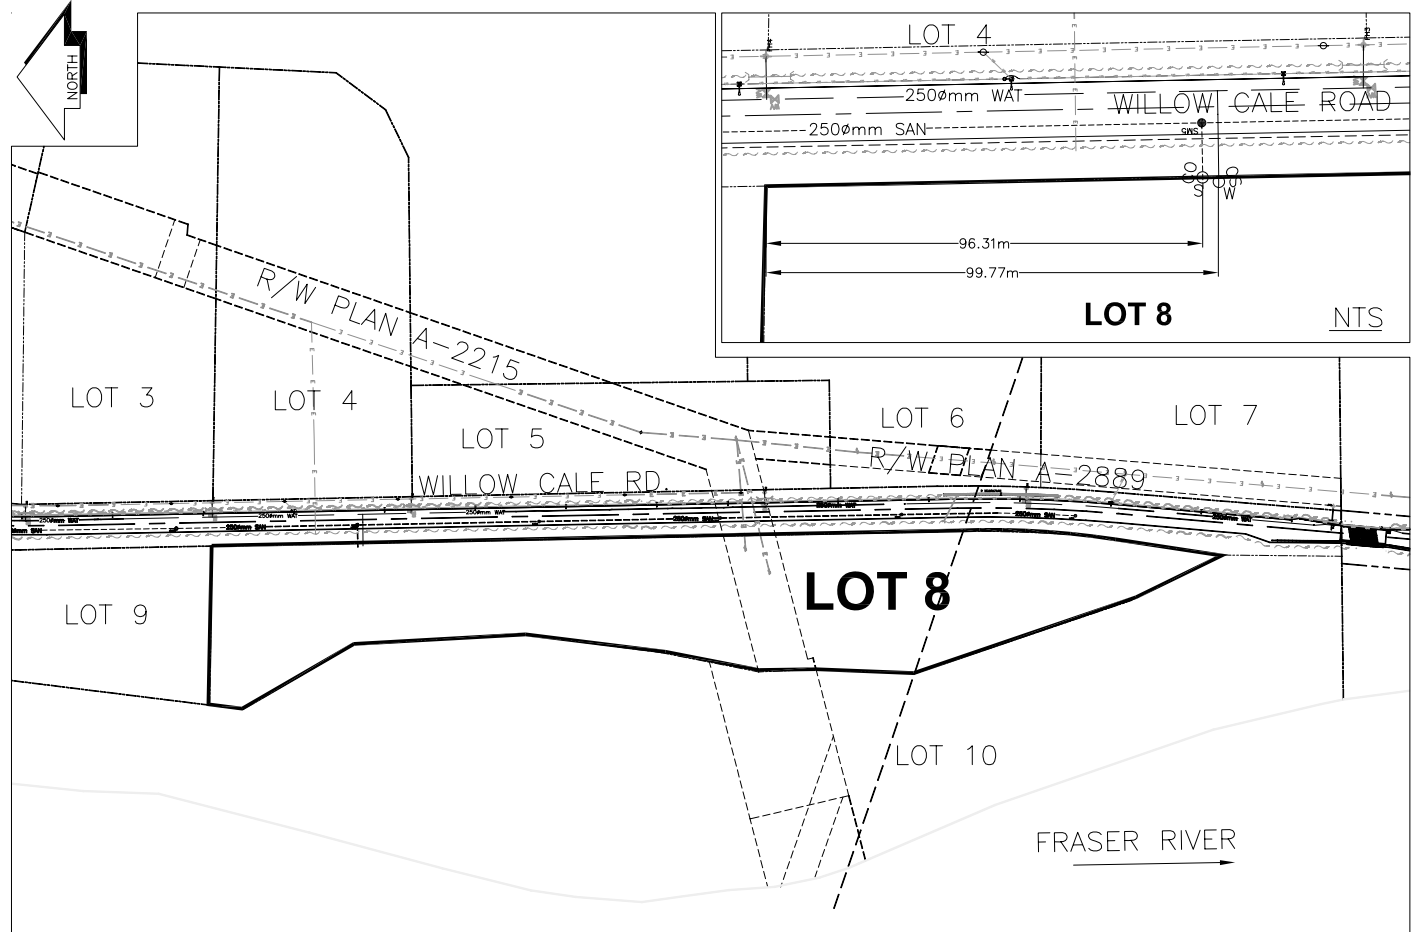

SANITARY, STORM & WATER SERVICE INVERTS	SANITARY	WATER	STORM
1. Distance from San. M.H. <u> #4 </u> toward San. M.H. <u> #5 </u> to lot service connection point is:	120.1m	116.6m	n/a
1a.Distance from Stm. M.H. <u> </u> - <u> </u> toward Stm. M.H. <u> </u> - <u> </u> to lot service connection point is:	n/a	n/a	n/a
2. Main Size at connection point is	250mmØ	250mmØ	n/a
3. Invert of main at conn. stub point is	581.96m	584.17m	n/a
4. Invert at service end is	582.25m	584.86m	n/a
5. Cut at property line in meters	3.7m	3.4m	n/a
6. Survey Date:08/01/29 Book Ref.: - By: AllNorth			

SANITARY HISTORY:

WATER HISTORY:

STORM HISTORY:
