


Lot Servicing

4688 VELLENCER RD

PID: 027740111

Lot: PCL A, **Plan:** BCP39189, **DL:** 4048

SERVICE	SIZE	MATERIAL	INSTALLED DATE	LOCATION	DETAILS
WATER	20MM	UNKNOWN		7.5M E OF W PL WATER AND SANITARY CONNECTIONS ARE COMMON TRENCHED	
WATER	20MM	UNKNOWN		33.016M E OF W PL WATER AND SANITARY CONNECTIONS ARE COMMON TRENCHED	
SANITARY	100MM	UNKNOWN		7.5M E OF W PL OFF VELLENCER WATER AND SANITARY CONNECTIONS ARE COMMON TRENCHED	ELEV OF INVERT @ P/L 790.417
SANITARY	100MM	UNKNOWN		33.016M E OF W PL WATER AND SANITARY CONNECTIONS ARE COMMON TRENCHED	ELEV OF INVERT @ P/L 790.416

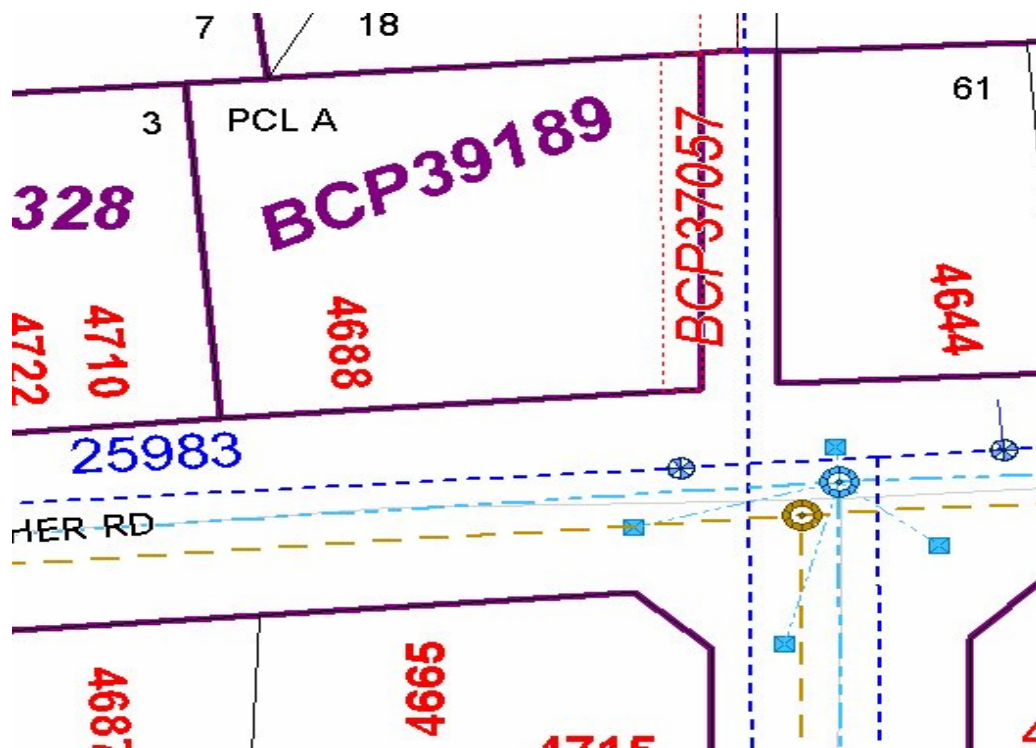

Accuracy not guaranteed unless confirmed by site inspection and/or investigation.
Connection location between main and property line only.