


Lot Servicing

2121 MCLAREN RD E

PID 027750850

Lot: 1, Plan: BCP39281, DL: 635

SERVICE	SIZE	MATERIAL	INSTALLED DATE	LOCATION	DETAILS
WATER	20MM	UNKNOWN		8.5M S OF N PL	
SANITARY	100MM	PVC		13.41M S OF N PL	CUT @ P/L @ DATE OF INSTALLATION 2.74

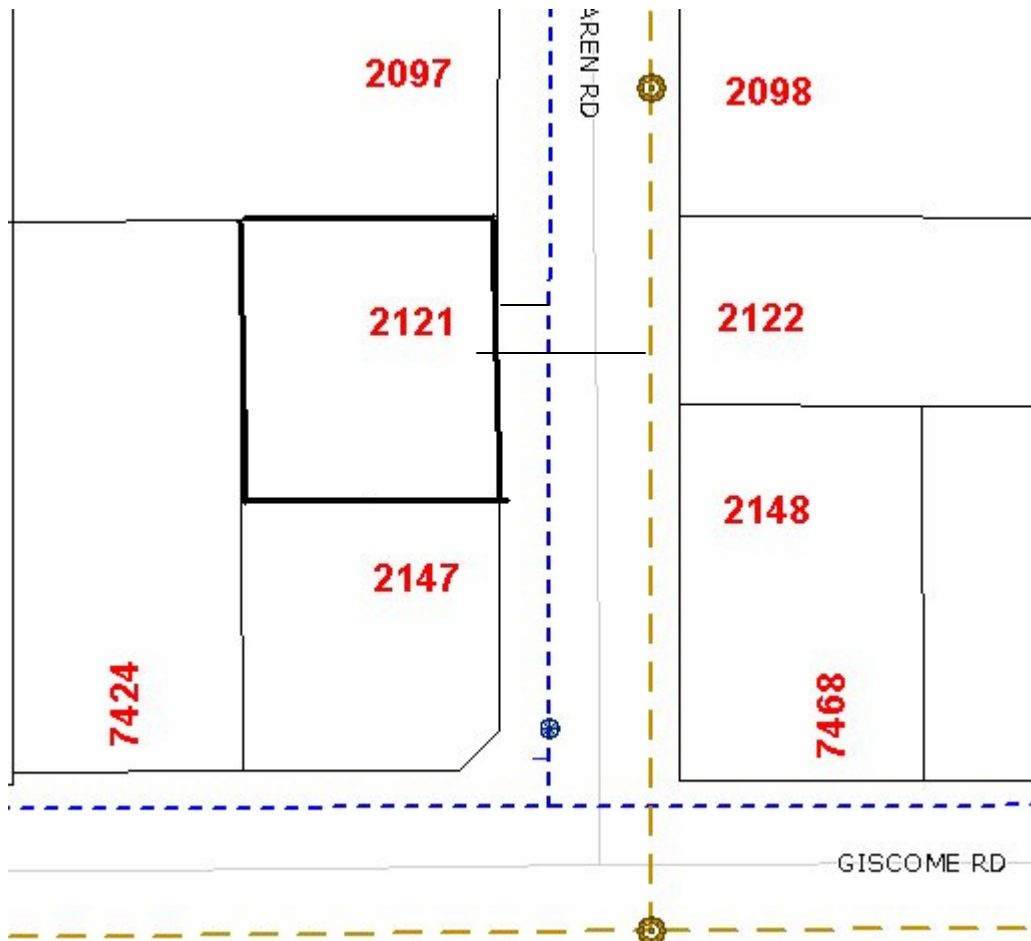

Accuracy not guaranteed unless confirmed by site inspection and/or investigation.
Connection location between main and property line only.