


Lot Servicing

4302 AUSTIN RD W

PID: 027764281

Lot: A, Plan: BCP39370, DL: 4047

SERVICE	SIZE	MATERIAL	INSTALLED DATE	LOCATION	DETAILS
WATER	20MM	CU		FR SW COR BLD 14.935M S 1.52M W	THAW WIRE Y
SANITARY	100MM	UNKNOWN		5.7M W OF SE COR PL	CONNECTION # 12396
STORM	100MM	PVC		8.0M E OF W PL RUNS INTO MANHOLE	CONNECTION # 34537

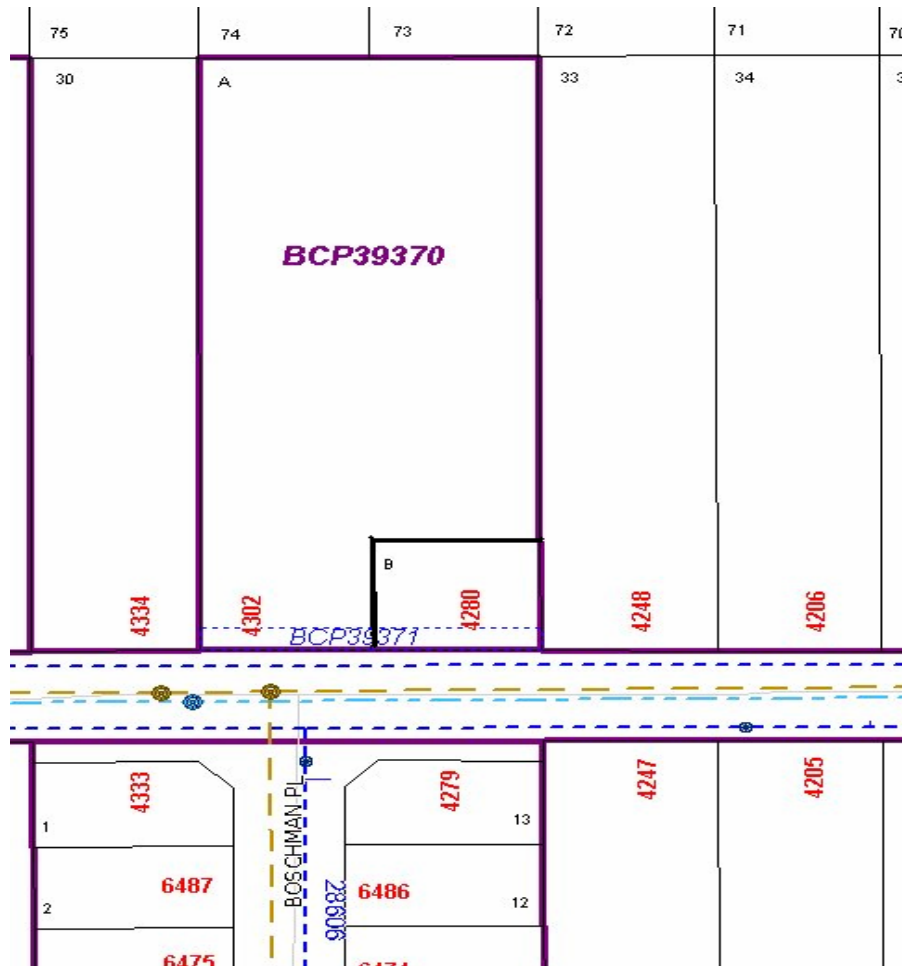

Accuracy not guaranteed unless confirmed by site inspection and/or investigation.
Connection location between main and property line only.