

### Lot Servicing


4280 AUSTIN RD W

PID

027764290

**Lot: B, Plan: BCP39370, DL: 4047**

SERVICE	SIZE	MATERIAL	INSTALLED DATE	LOCATION	DETAILS
WATER	20MM	CU		11.6M E OF SW COR PL ; FR SE COR BLD 10.058M S 0.609M W	THAW WIRE Y
SANITARY	100MM	PVC		9.8M W OF SE COR PL	CONNECTION # 12397
STORM	100MM	PVC		1.0M E OF W PL	CONNECTION # 34537

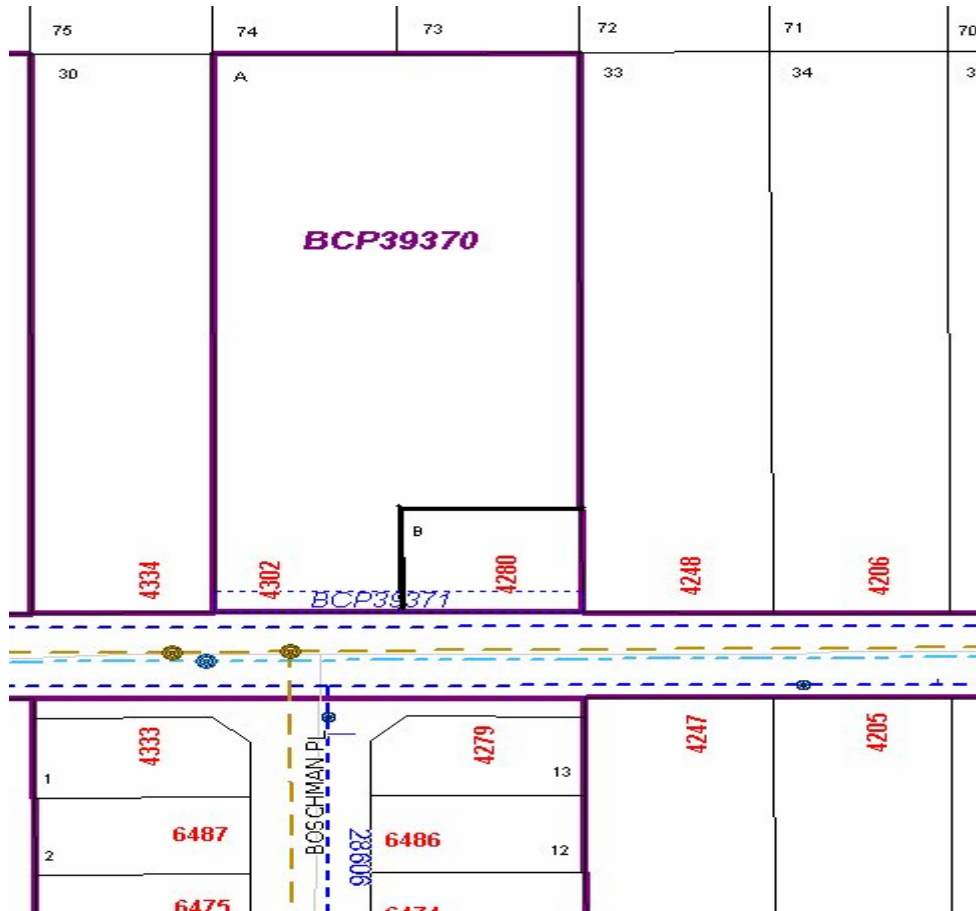

Accuracy not guaranteed unless confirmed by site inspection and/or investigation.  
Connection location between main and property line only.