


## Lot Servicing

1673 NORWOOD ST

PID: 027811077

**Lot:** PCL A, **Block:** 263, **Plan:** 1268, **DL:** 343

SERVICE	SIZE	MATERIAL	INSTALLED DATE	LOCATION	DETAILS
WATER	20MM	CU		FR SE COR BLD 7.6M E 5.5M S	CONNECTION NUMBER 7641
SANITARY	UNKNOWN	UNKNOWN		15.849M N OF SE COR PL	CONNECTION # 619

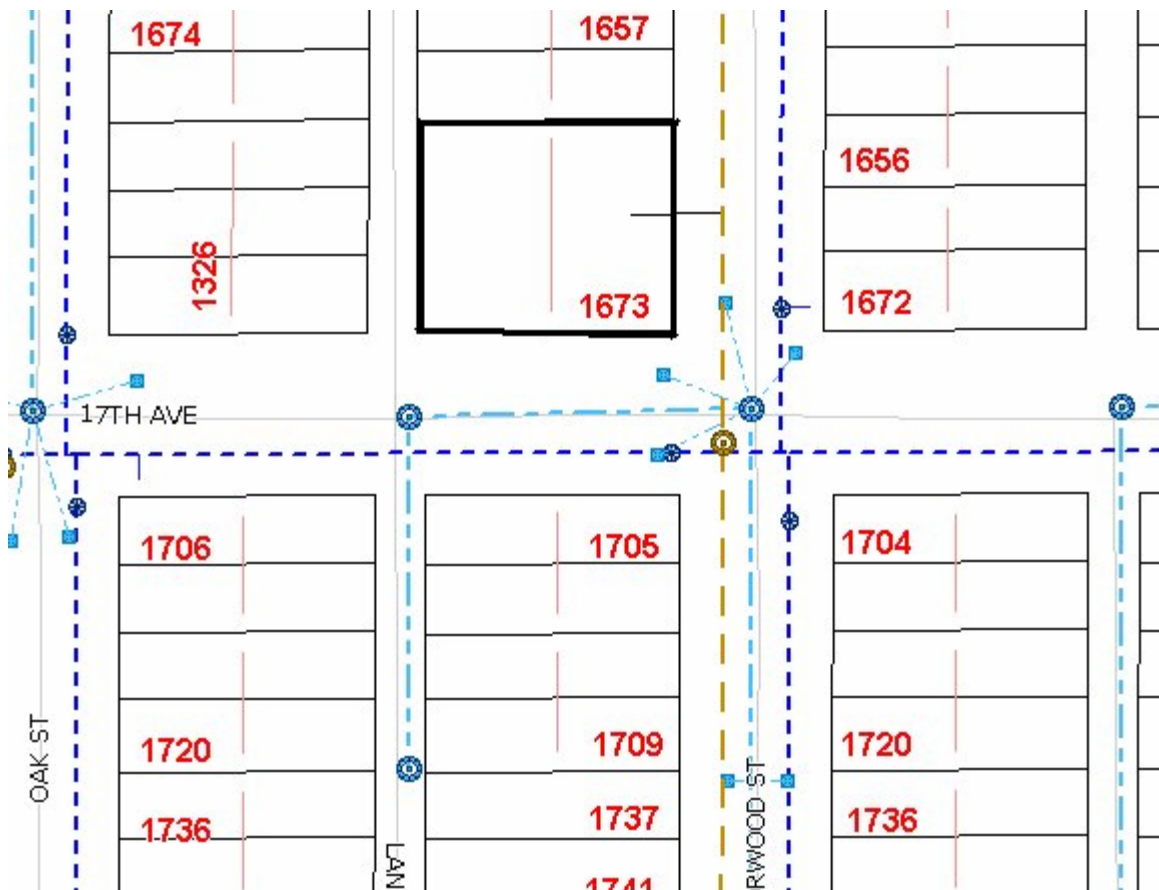

Accuracy not guaranteed unless confirmed by site inspection and/or investigation.  
Connection location between main and property line only.