


## Lot Servicing

1085 3RD AVE    304 GEORGE ST

**PID: 027827194**

**Lot: PCL B, Block: 135, Plan: 1268, DL: 343 (BB755174)**

SERVICE	SIZE	MATERIAL	INSTALLED DATE	LOCATION	DETAILS
WATER	20MM	CU		18.288M S OF NW COR PL 2.3M W ( IN STREET ) - DISCONNECTED 2009	
WATER	UNKNOWN	UNKNOWN		NO LOCATION GIVEN	CONNECTION NUMBER 2291
WATER	50MM	UNKNOWN	13-Jul-2009	NEW SERVICE NO LOCATION	CASH RECEIPT NUMBER 100967
SANITARY	UNKNOWN	UNKNOWN		8.84M S OF N PL (IN LANE)	CONNECTION # 2375
SANITARY	UNKNOWN	UNKNOWN		10.972M S OF N PL (IN LANE)	CONNECTION # 2376
SANITARY	100MM	UNKNOWN		0.609M N OF S COR PL ( IN LANE )	CONNECTION # 2645

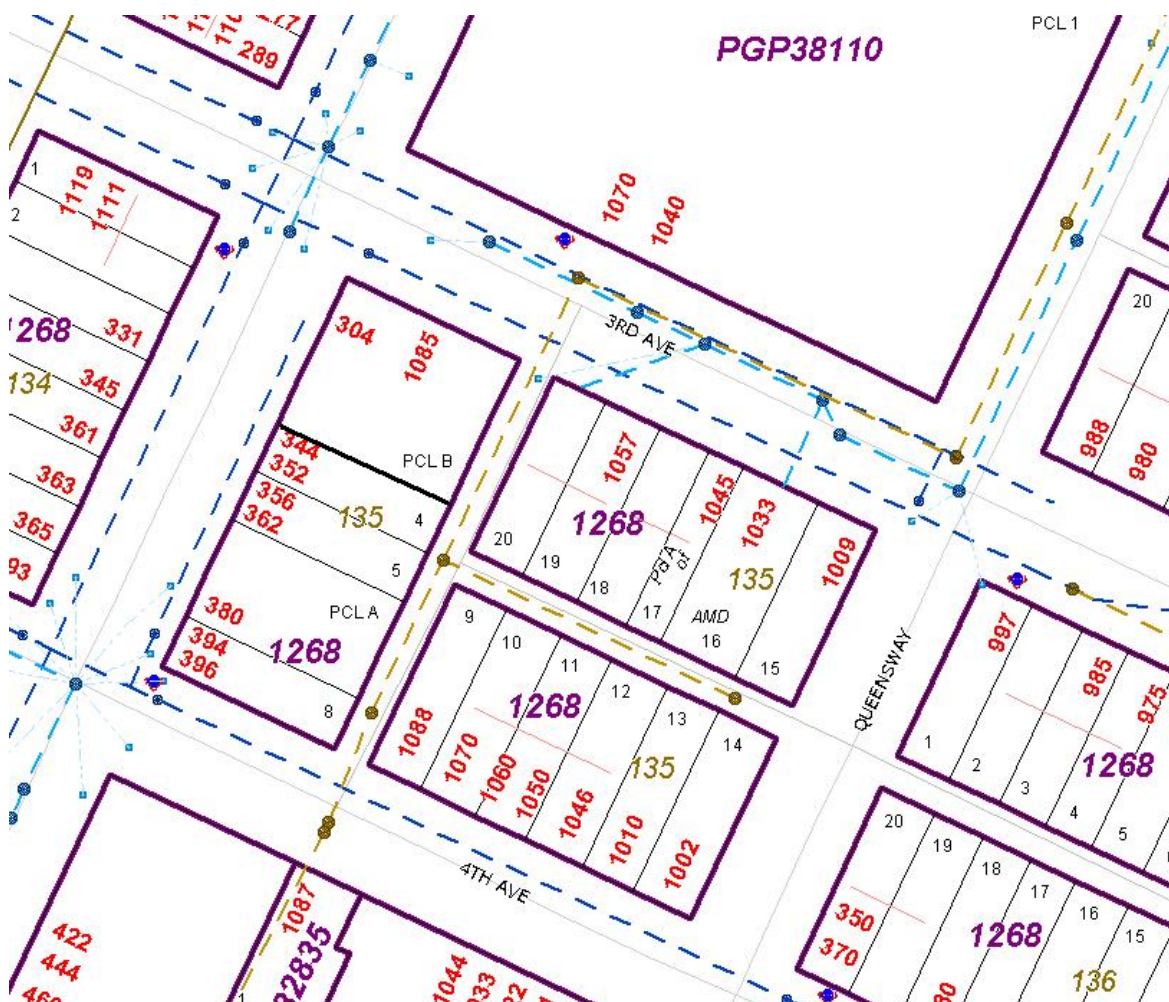

Accuracy not guaranteed unless confirmed by site inspection and/or investigation.  
Connection location between main and property line only.

