

# City of Prince George

## HISTORY SHEET

PID: 015-048-781 027828051

Legal: LOT 1 D.L. - 749 PLAN - BCP39874

Address: WILLOW CALE ROAD 1077 BOUNDARY RD SCALE: 1 : 10,000

Sanitary Connection:# SIZE: MATERIAL: - INV. CONNECTED

Water Connection:# SIZE: 50mmØ MATERIAL: COPPER INV. 579.87 METER

Storm Connection:# SIZE MATERIAL: - INV. CONNECTED

Cash Receipt No's: WATER SANITARY STORM

CURB FROM PROPERTY LINE -m PAVEMENT WIDTH 12m

B.C. HYDRO U/G CONNECTION ✓

B.C. TELEPHONE U/G CONNECTION ✓


B.C. GAS

Information Sheets: REF. DWGS. L&M ENGINEERING LTD. JOB. 1126-13-3.2 DWGS (001-308)

Comments: CS CURB STOP SDW WATER SERVICE HYDRO SERVICE GAS GAS  
CO CLEAN OUT SDW STORM SERVICE CABLE SERVICE E ELECTRICAL  
FC TELECOMMUNICATIONS

THE INFORMATION CONTAINED HEREIN IS FOR INTERNAL USE ONLY.

NOT TO BE RELIED UPON UNLESS CONFIRMED BY THE SITE INSPECTION AND/OR INVESTIGATION

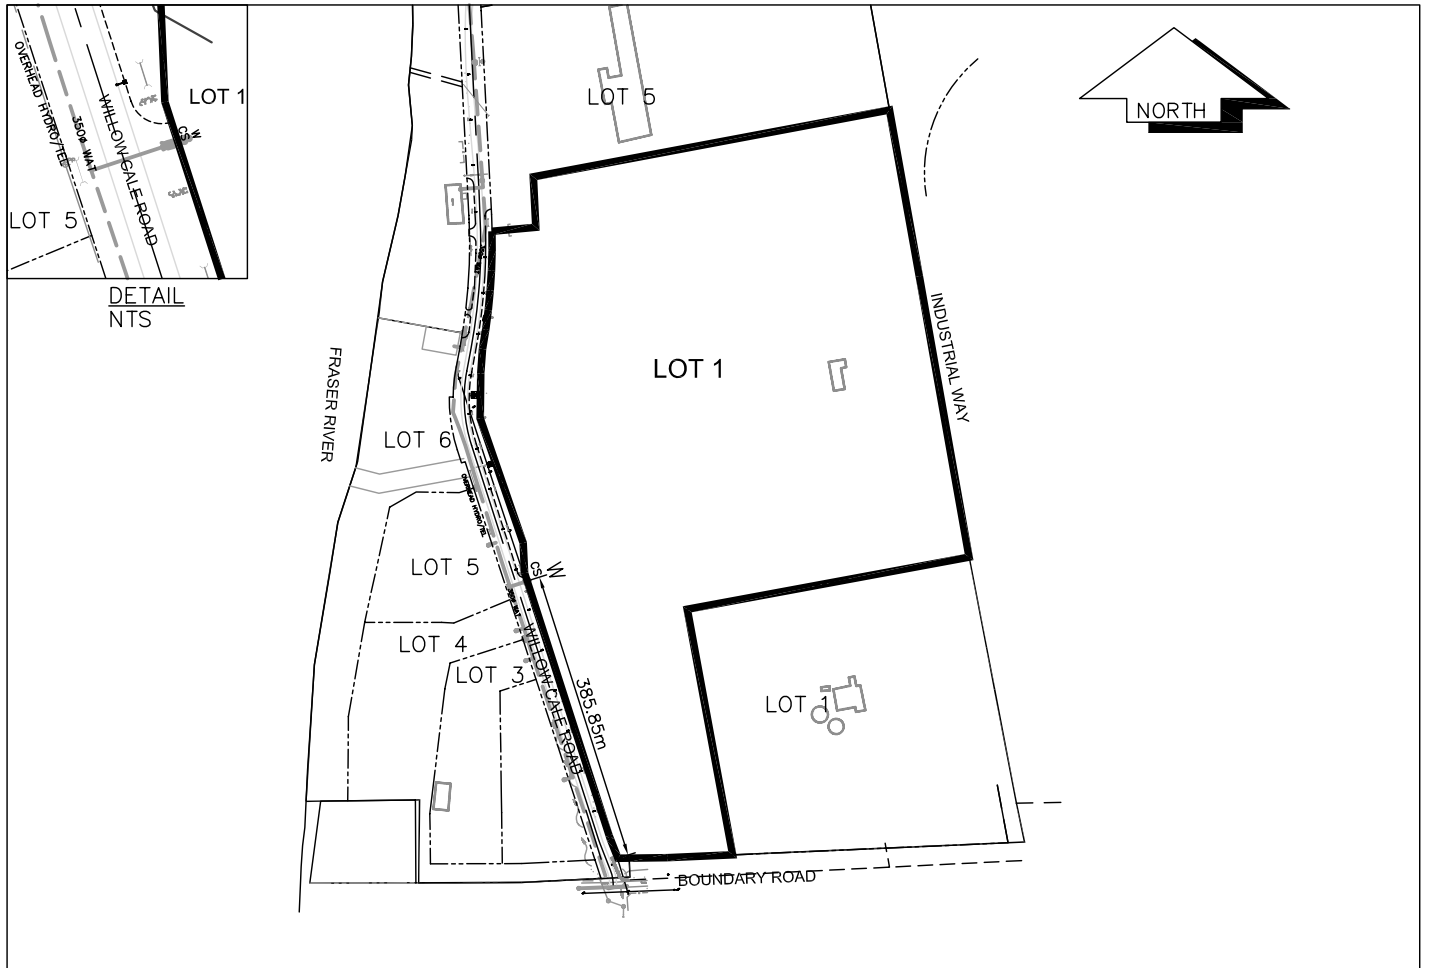

SANITARY, STORM & WATER SERVICE INVERTS	SANITARY	WATER	STORM
1. Distance from San. M.H. toward San. M.H. to lot service connection point is:	N/A	N/A	N/A
1a.Distance from Stm. M.H. toward Stm. M.H. to lot service connection point is:	N/A	N/A	N/A
2. Main Size at connection point is	N/A	350mmØ	N/A
3. Invert of main at conn. stub pt is	N/A	580.41m	N/A
4. Invert at service end is	N/A	579.87m	N/A
5. Cut at P/I in meters	N/A	2.85m	N/A
6. Survey Date: JULY 06    Book Ref.: 1126-13-3.2 By: Allnorth Engineering			

SANITARY HISTORY:

---

---

WATER HISTORY:

---

Water service was insulated with Hi-40 styrofoam insulation 100mm thickness at culvert crossing.

---

---

STORM HISTORY:

---

---

