



City of Prince George History Sheet

PID:	027840921
MU:	101247
WO:	61498

Civic Address: 760 Kinsmen Pl

Legal Description: Lot: 1& DL 2610 District Lot: 937 Plan: BCP40230


Service Type	Diameter (mm)	Material	Invert Elev at main (m)	Invert Elev at property line (m)	Invert Elev at service end (m)	Distance into property (m)	Installation Date
Sanitary	200mm	PVC	601.73	601.76	-	-	October 2011
Water	150mm	PVC	602.38	602.60	-	-	October 2011
Storm	250mm	PVC	601.50	601.57	-	-	October 2011

Service Connection Location	Sanitary (m)	Storm (m)
200mm Sanitary service connected to San MH in boulevard on 5th Ave	-	
250 Storm service connected to Stm MH 263		

Power	Size	Communications	Size	Cable	Size	Gas	Size
BC Hydro	-	Telus	-	Shaw	-	FortisBC	-
Underground Service		Underground Service		Underground Service			

Installed by:	City of Prince George forces	Survey Date:	-
Comments:	Existing Water, Samitary and Storm on Kinsmen Pl disconnected and abandoned - October 2011		

NOT TO SCALE The information contained herein is for internal use only.
Not to be relied on unless confirmed by site inspection and/or investigation.

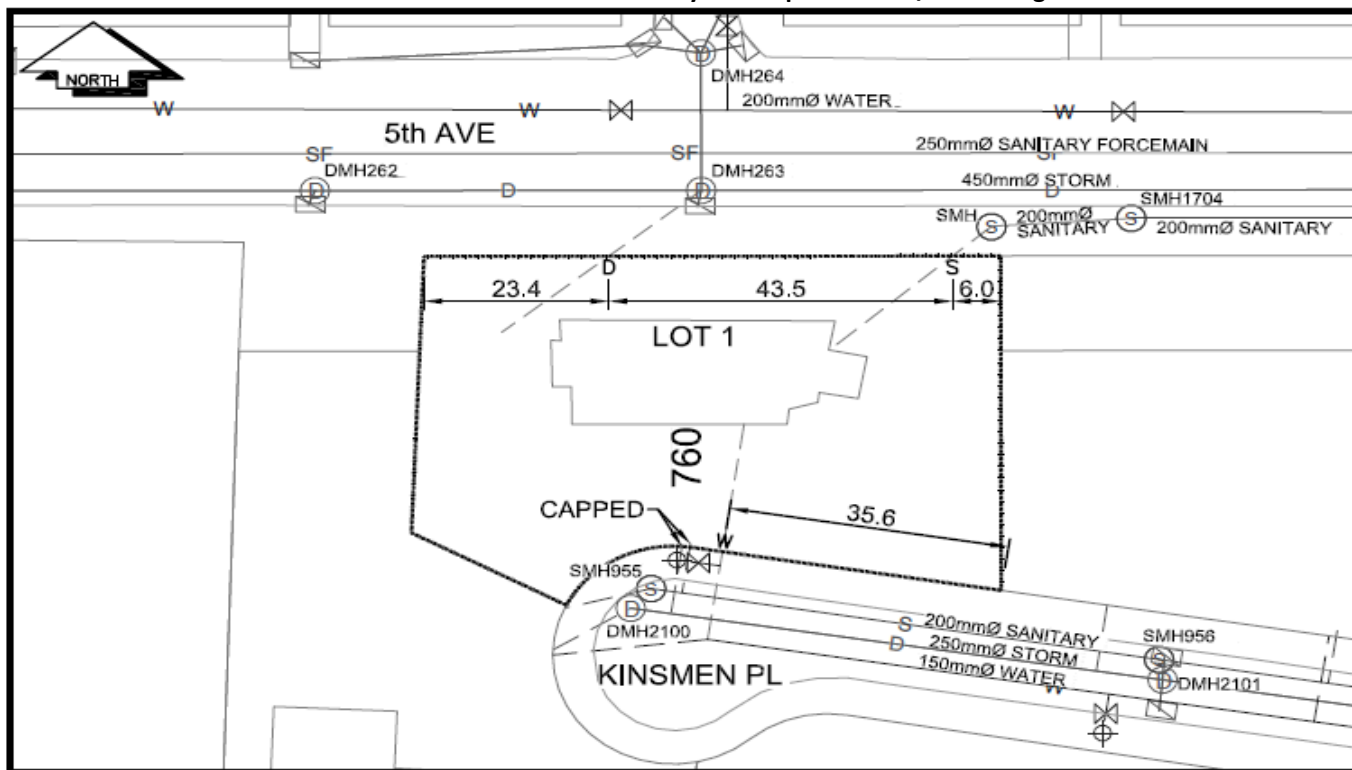

LEGEND:	CS CURB STOP	--- WATER SERVICE	--- STORM SERVICE
	CO CLEAN OUT	--- SANITARY SERVICE	--- GAS

NOT TO SCALE