


## Lot Servicing

385 MOFFAT ST

PID: 027855741

**Lot:** PCL D, **Block:** 132, **Plan:** 752, **DL:** 938

SERVICE	SIZE	MATERIAL	INSTALLED DATE	LOCATION	DETAILS
WATER	20MM	CU	08-Aug-1956	FR NE COR BLD 8.1M E 2.4M S	CONNECTION NUMBER 1679
WATER	20MM	CU	25-May-1959	NO LOCATION	CONNECTION NUMBER 1680
SANITARY	UNKNOWN	UNKNOWN		11.887M N OF S PL	CONNECTION # 3077

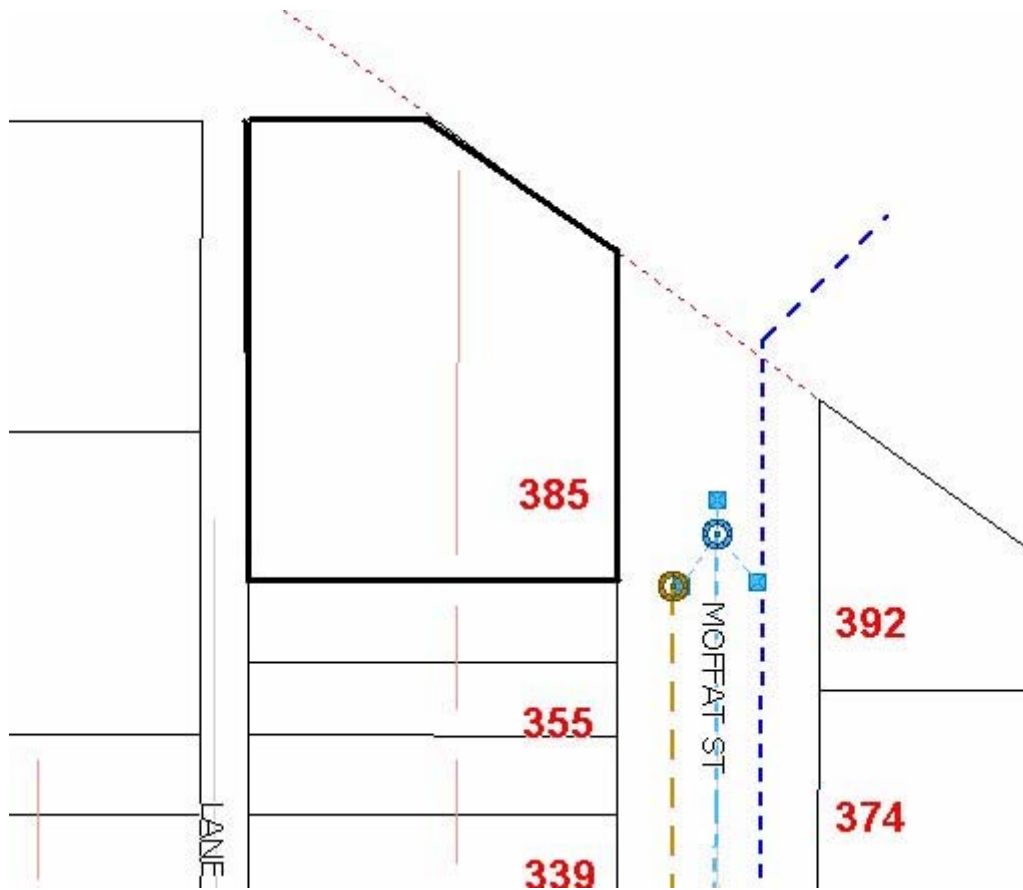

Accuracy not guaranteed unless confirmed by site inspection and/or investigation.  
Connection location between main and property line only.