


Lot Servicing

4341 FOSTER PL

PID: 027879674

Lot: A, Plan: BCP40526, DL: 2003

SERVICE	SIZE	MATERIAL	INSTALLED DATE	LOCATION	DETAILS
WATER	19MM	CU			
SANITARY	100MM	PVC			CUT @ P/L @ DATE OF INSTALLATION 425.23
STORM	UNKNOWN	UNKNOWN			CUT @ P/L @ DATE OF INSTALLATION 2.56M

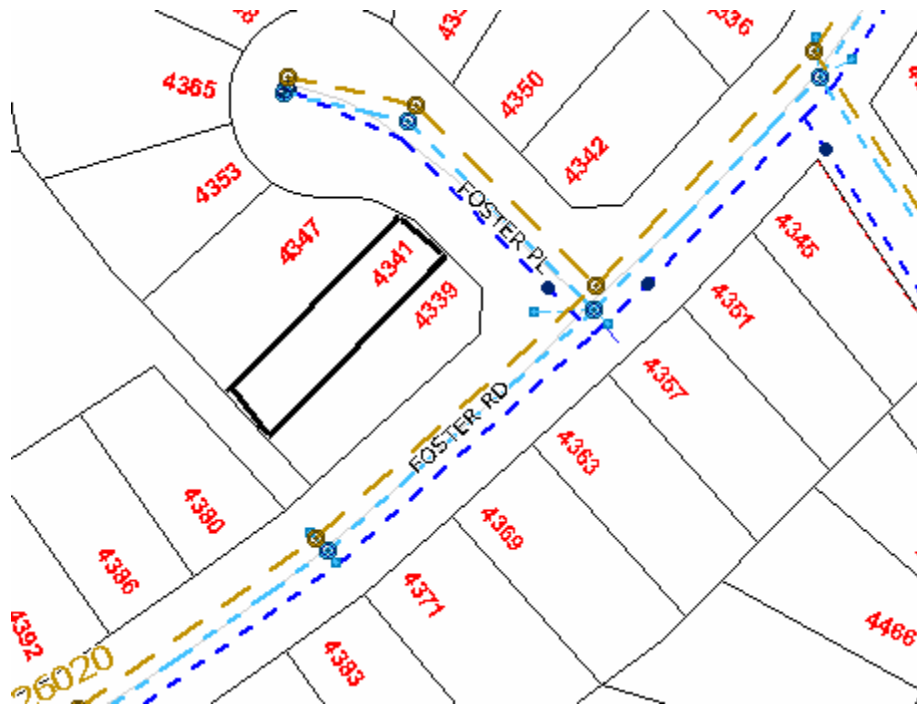

Accuracy not guaranteed unless confirmed by site inspection and/or investigation.
Connection location between main and property line only.

