


Lot Servicing

4339 FOSTER PL

PID: 027879682

Lot: B, **Plan:** BCP40526, **DL:** 2003

SERVICE	SIZE	MATERIAL	INSTALLED DATE	LOCATION	DETAILS
WATER	19MM	CU		FR SW CORN BLDG 3.5M SE 13.7M SW	
SANITARY	100MM	PVC		CLEANOUT SW COR BLDG 1.6M SE 3M SW	CLEANOUT SW COR BLD 1.6
STORM	UNKNOWN	UNKNOWN			DIFF OR CUT @ P/L 1.61M

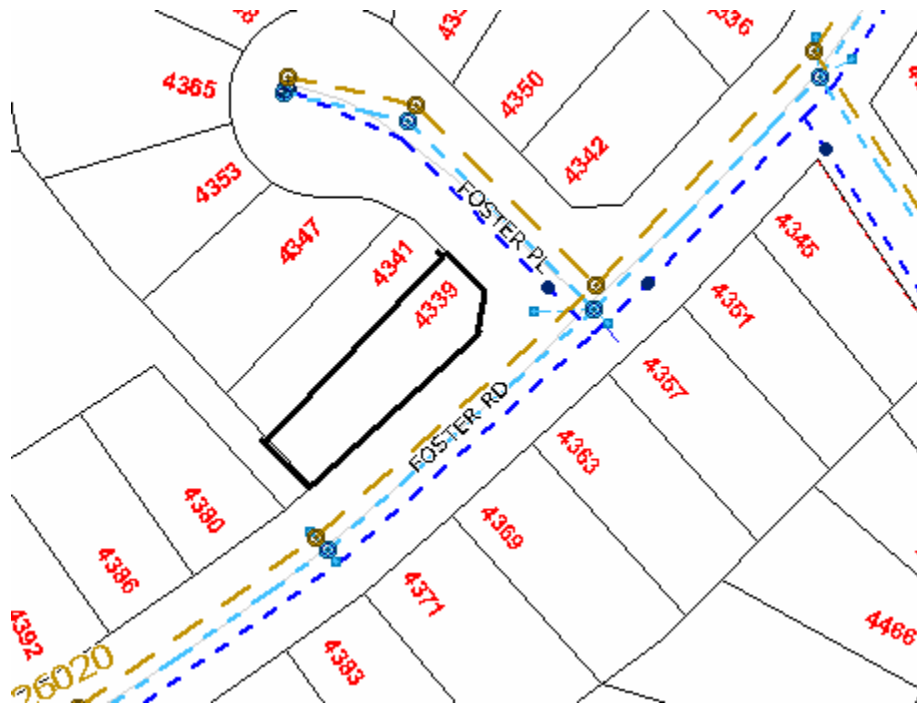

Accuracy not guaranteed unless confirmed by site inspection and/or investigation.
Connection location between main and property line only.