


Lot Servicing

1650 GORSE ST

PID: 027882241

Lot: PCL C, **Block:** 254, **Plan:** 1268, **DL:** 343

| SERVICE | SIZE | MATERIAL | INSTALLED DATE | LOCATION | DETAILS |
|----------|---------|----------|----------------|------------------------------|-----------------------|
| WATER | 20MM | CU | 22-May-1958 | FR NW COR BLD 11.5M W 4.9M S | CONNECTION NUMBER 430 |
| SANITARY | UNKNOWN | UNKNOWN | | 7.312M S OF NW COR PL | CONNECTION # 579 |

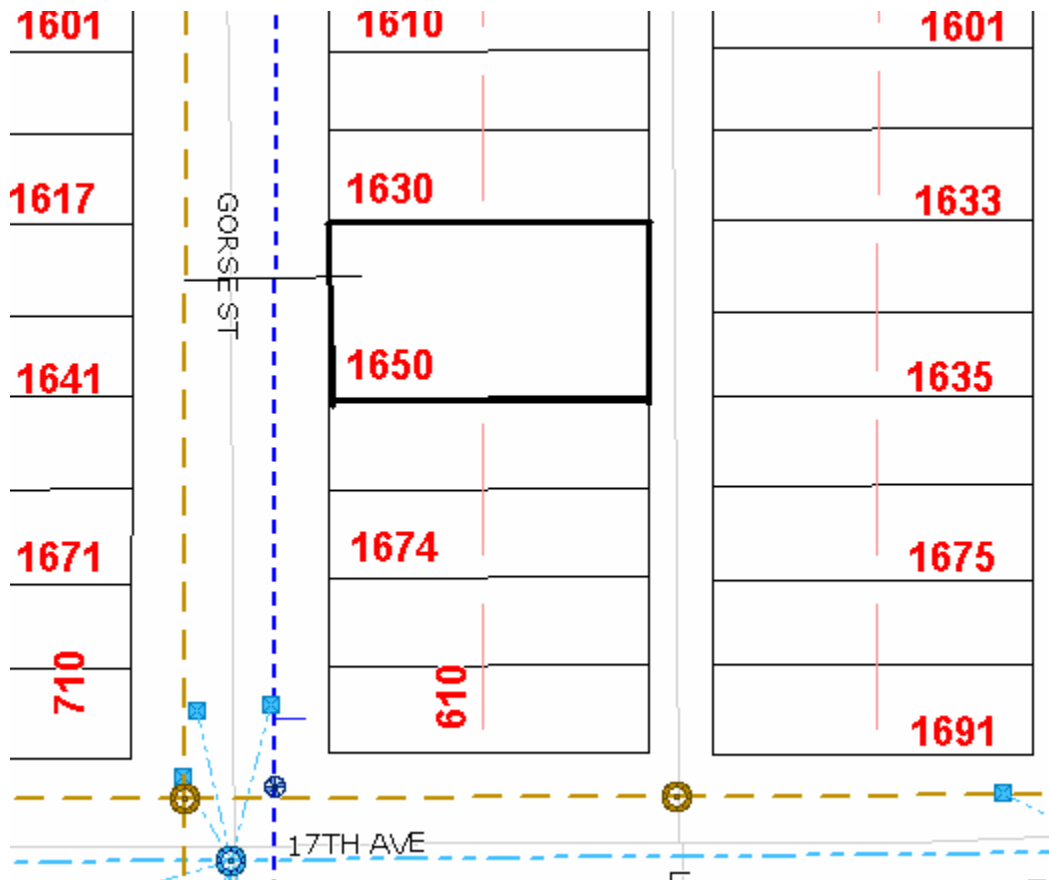

Accuracy not guaranteed unless confirmed by site inspection and/or investigation.
Connection location between main and property line only.