


Lot Servicing

1704 MAPLE ST

PID: 027902803

Lot: PCL C, **Block:** 286, **Plan:** 1268, **DL:** 343 (BB1065658)

SERVICE	SIZE	MATERIAL	INSTALLED DATE	LOCATION	DETAILS
WATER	20MM	CU		FR NW COR BLD 8.9M W 3.0M S	CONNECTION NUMBER 2326
SANITARY	100MM	PVC		7.62M N OF SW COR PL	CLEANOUT FR NW COR BLD 7M W 7M S

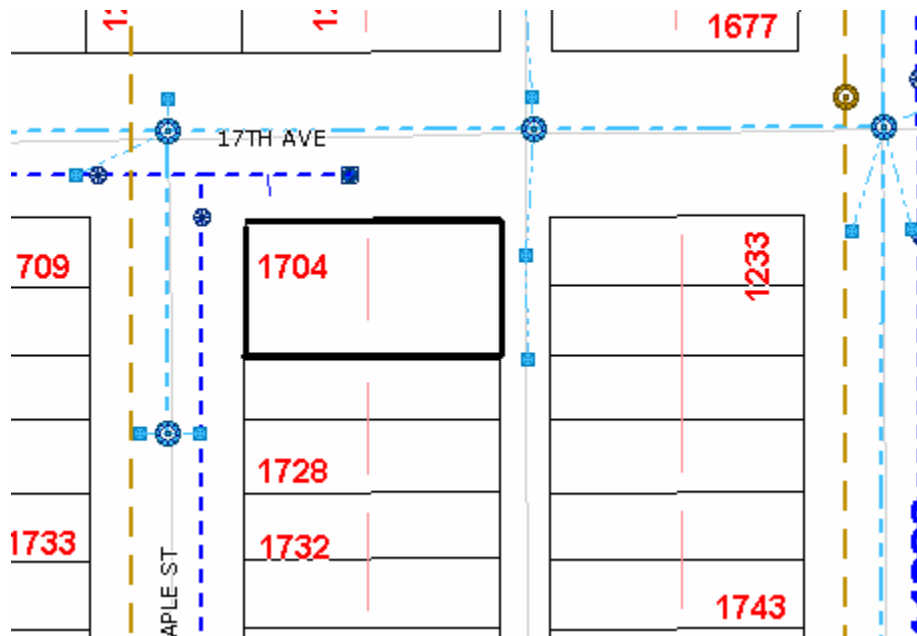

Accuracy not guaranteed unless confirmed by site inspection and/or investigation.
Connection location between main and property line only.