



City of Prince George History Sheet

PID:	027902927
MU:	101303
WO:	

Civic Address: 1023 Central St

Legal Description: Lot: 1 District Lot: 936 Plan: BCP40770


Service Type	Diameter (mm)	Material	Invert Elev at main (m)	Invert Elev at property line (m)	Invert Elev at service end (m)	Distance into property (m)	Installation Date
Sanitary	150mm	PVC	597.39	597.50	597.50	-	Aug 2013
Water	100mm	PVC	-	598.48	-	-	Aug 2013
Storm	250mm	PVC	598.38	598.45	598.65	3.00	Aug 2013

Service Connection Location	Sanitary (m)	Storm (m)
New sanitary service connection connected to new 1050mm MH on Commercial St	-	
Distance from Stm MH 2118 towards Stm MH 3170		52.40

Power	Size	Communications	Size	Cable	Size	Gas	Size
BC Hydro	-	Telus	-	Shaw	-	FortisBC	-
Underground Service		Underground Service		Underground Service			

Installed by: CoPG forces	Survey Date: -
Comments: Storm connection wye'd into 600mm storm main	

NOT TO SCALE The information contained herein is for internal use only.
Not to be relied on unless confirmed by site inspection and/or investigation.

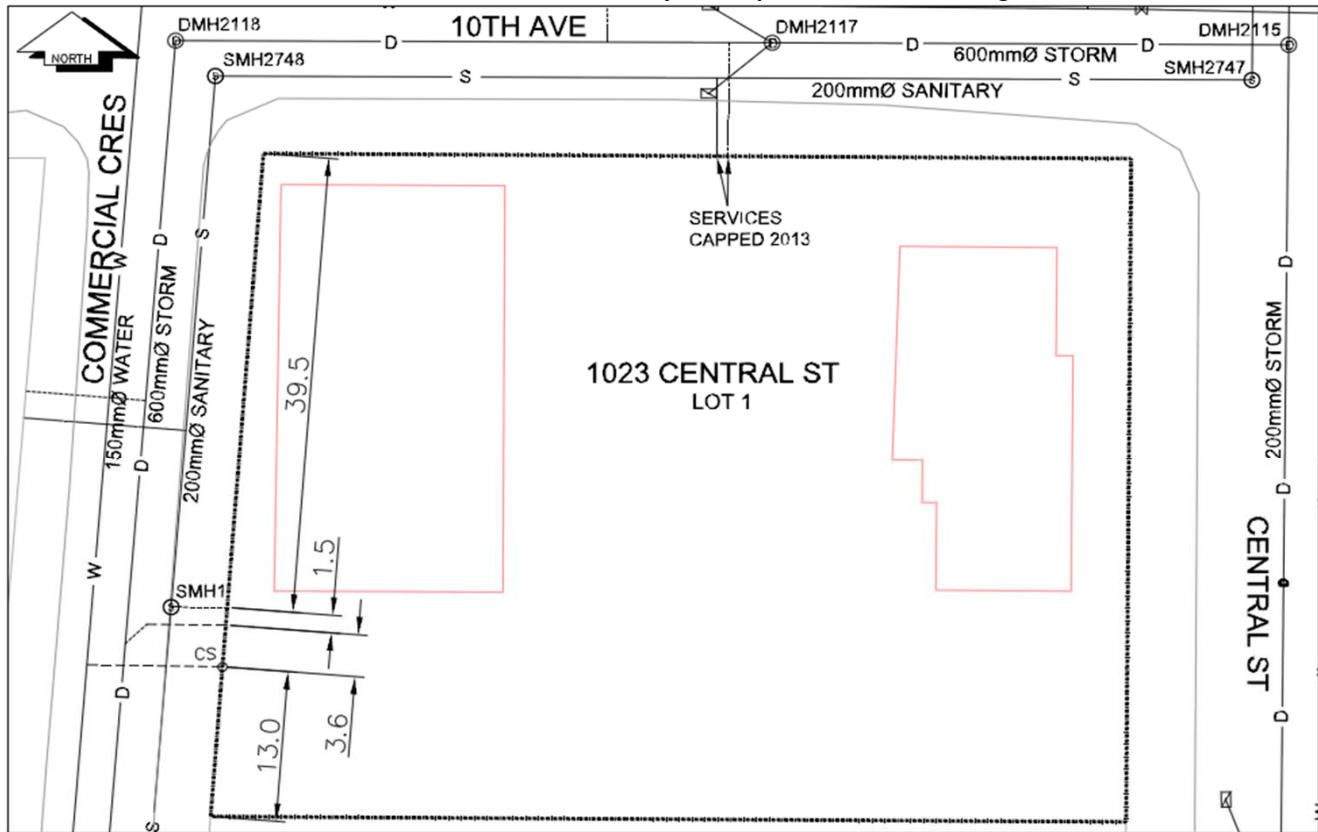

CS ^o CURB STOP	--- W WATER SERVICE	--- S STORM SERVICE
CO ^o CLEAN OUT	--- S SANITARY SERVICE	⊗ WATER VALVE

NOT TO SCALE