


Lot Servicing

3019 CHARELLA PL

PID: 027903028

Lot: A, Plan: BCP40811, DL: 9261

SERVICE	SIZE	MATERIAL	INSTALLED DATE	LOCATION	DETAILS
WATER	20MM	CU		NO LOCATION	CASH RECEIPT NUMBER 100926
SANITARY	100MM	PVC		NO LOCATION	RECEIPT # 100926

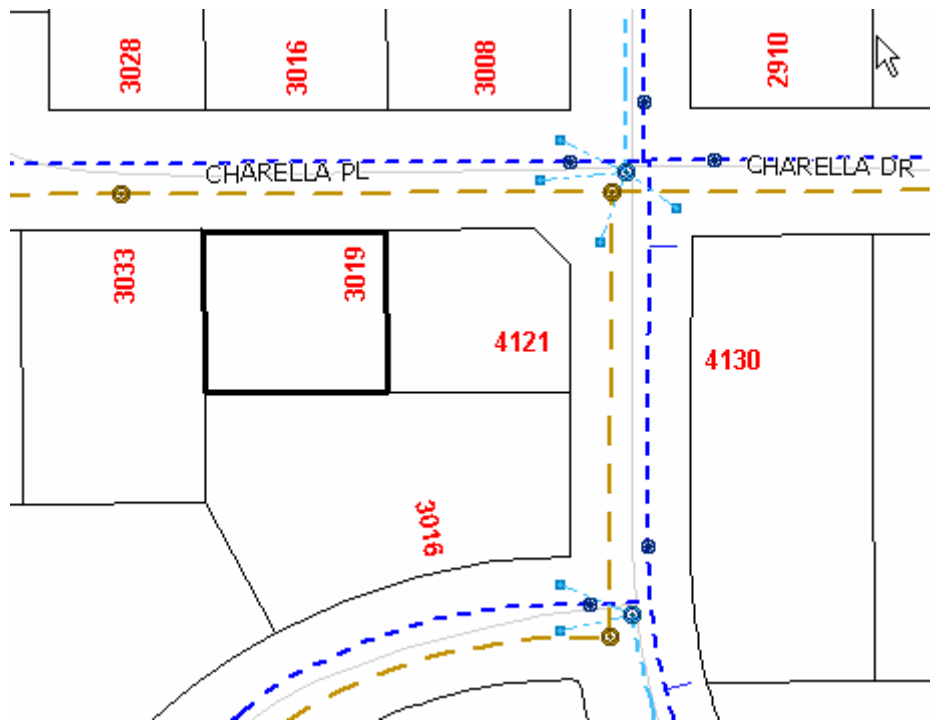

Accuracy not guaranteed unless confirmed by site inspection and/or investigation.
Connection location between main and property line only.