


## Lot Servicing

4121 DAVIS RD

PID: 027903036

**Lot:** B, **Plan:** BCP40811, **DL:** 9261

SERVICE	SIZE	MATERIAL	INSTALLED DATE	LOCATION	DETAILS
WATER	20MM	CU		FR NE COR BLD 9.0M E 5.0M S	
SANITARY	100MM	PVC	01-Jan-1980	19.7M W OF E PL OFF CHARELLA PL	CONNECTION # 14089

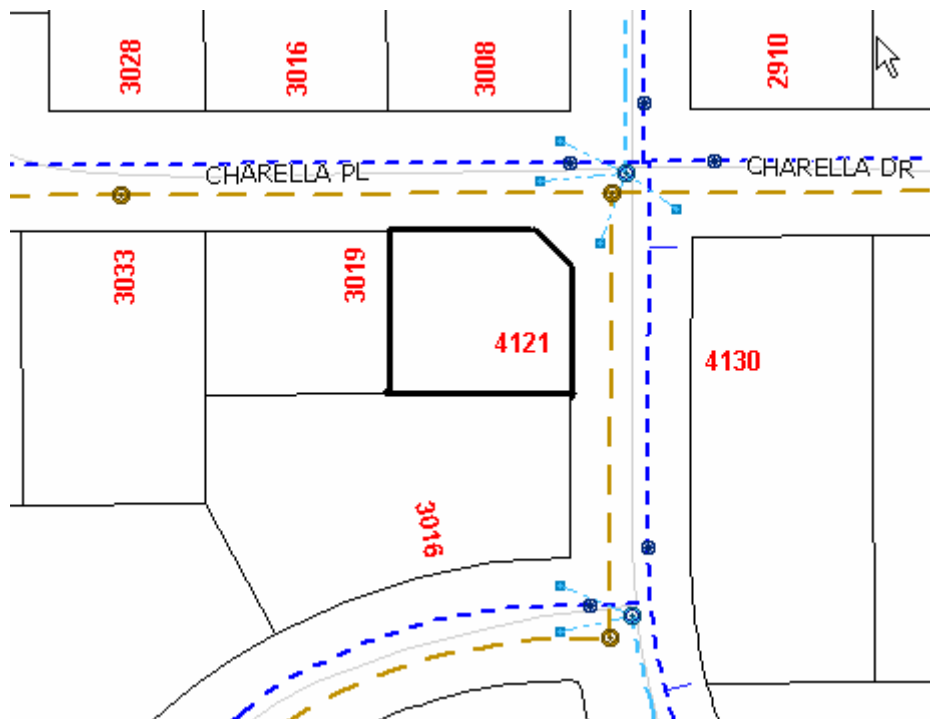

Accuracy not guaranteed unless confirmed by site inspection and/or investigation.  
Connection location between main and property line only.