


## Lot Servicing

993 DOUGLAS ST

PID: 027907384

**Lot:** PCL C, **Block:** 9, **Plan:** 646, **DL:** 1429

SERVICE	SIZE	MATERIAL	INSTALLED DATE	LOCATION	DETAILS
WATER	20MM	CU	15-Sep-1954	FR NE COR BLD 8.229M E 1.829M N	CONNECTION NUMBER 1355
SANITARY	UNKNOWN	UNKNOWN		2.139M N OF SE COR PL	CONNECTION # 1799

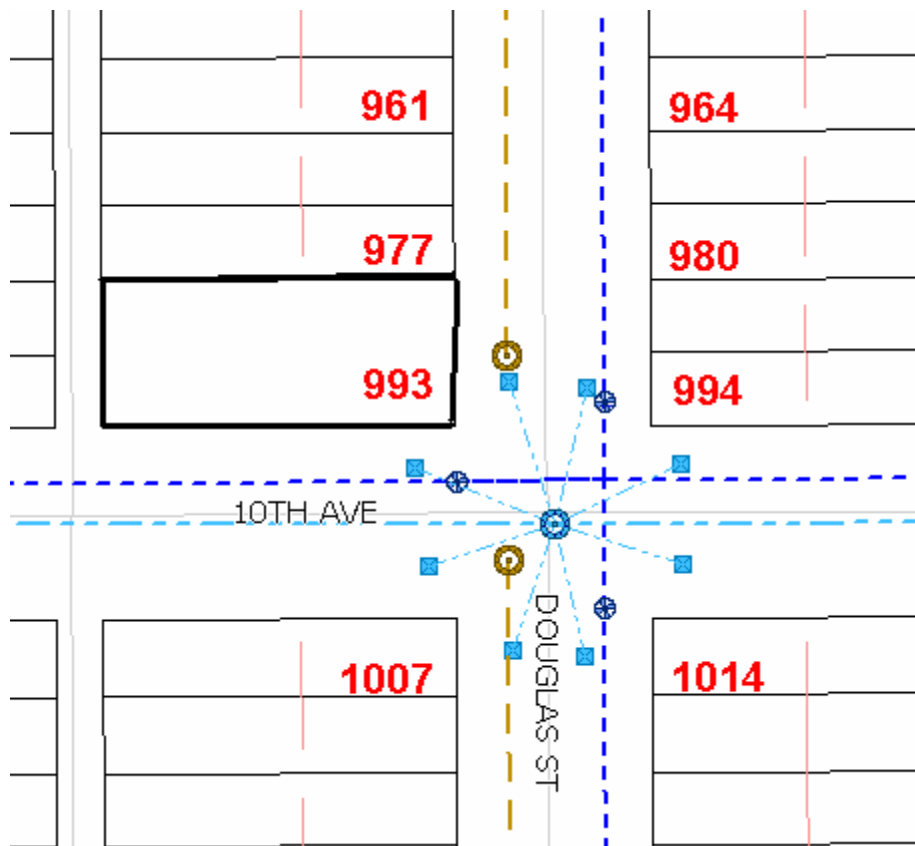

Accuracy not guaranteed unless confirmed by site inspection and/or investigation.  
Connection location between main and property line only.