


Lot Servicing

2662 VICTORIA ST 2670 VICTORIA ST
Lot: PCL A, **Plan:** 21751, **DL:** 1426

PID: 027913317

SERVICE	SIZE	MATERIAL	INSTALLED DATE	LOCATION	DETAILS
WATER	20MM	CU	01-Jan-1974	(2662) FR NW COR BLD 13.41M W 5.18M S	CASH RECEIPT NUMBER 79
WATER	20MM	CU	01-Jan-1974	(2670) FR SW COR BLD 13.41M W 5.48M N	CASH RECEIPT NUMBER 80
SANITARY	100MM	AC		(2662) 7.316M S OF N PL	CLEANOUT 0.3M S OF S PL
SANITARY	100MM	AC		(2670) 7.924M S OF N PL	CONNECTION # 9189

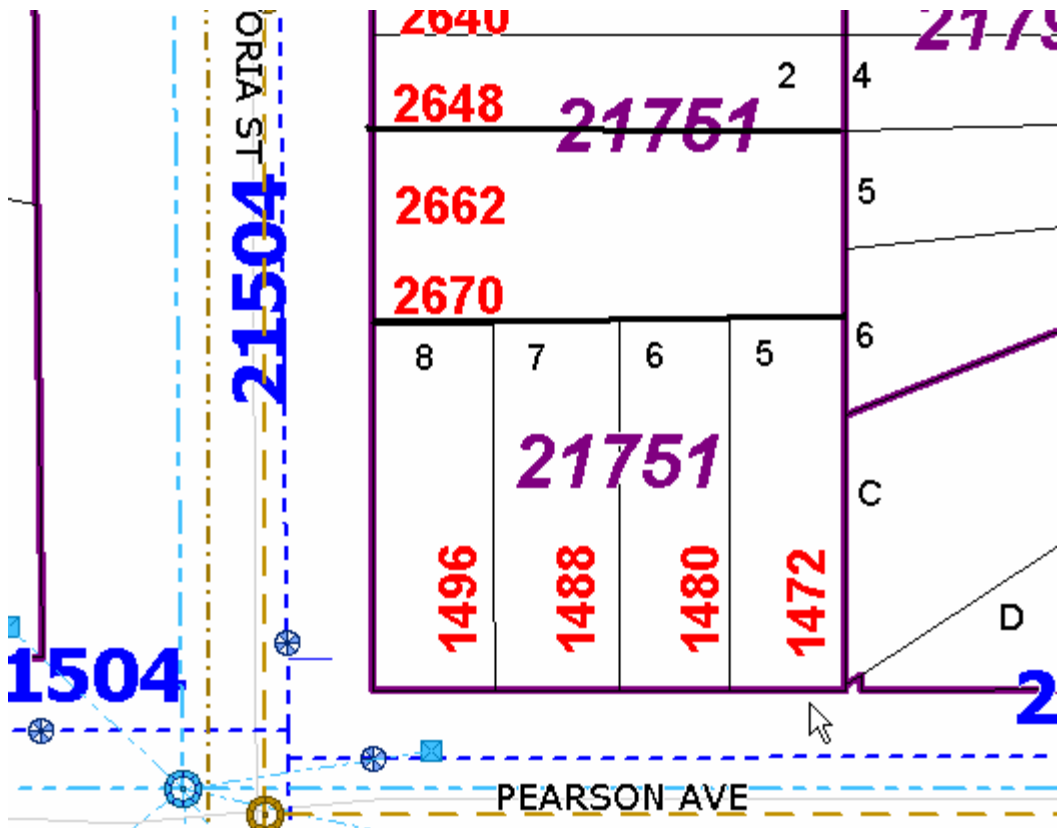

Accuracy not guaranteed unless confirmed by site inspection and/or investigation.
 Connection location between main and property line only.