


Lot Servicing

4051 DAVIS RD

PID: 027913325

Lot: A, Plan: BCP40876, DL: 9261

| SERVICE | SIZE | MATERIAL | INSTALLED DATE | LOCATION | DETAILS |
|----------|-------|----------|----------------|-------------------------------------|---|
| WATER | 20MM | CU | | FR NW COR BLD 19.3M N 3.2M W | THAW WIRE Y |
| SANITARY | 100MM | UNKNOWN | 01-Jan-1980 | 17.3M S OF N PL OFF DAVIS RD. | CLEANOUT FR NE COR PL 7.2M S 1.2M W |

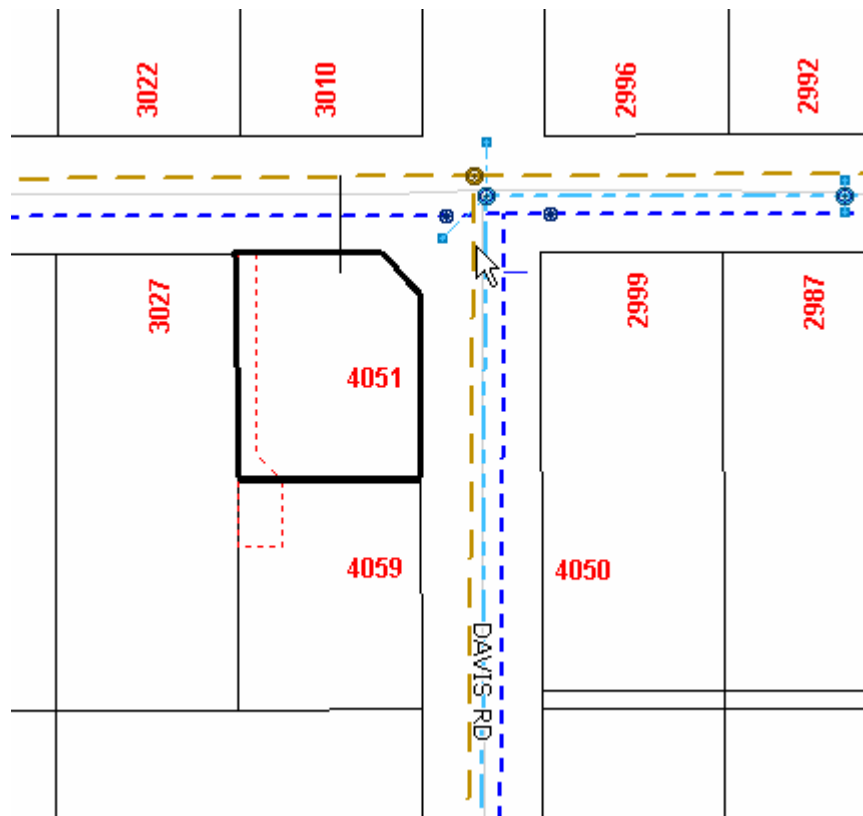

Accuracy not guaranteed unless confirmed by site inspection and/or investigation.
Connection location between main and property line only.