


Lot Servicing

4059 DAVIS RD

PID: 027913333

Lot: B, **Plan:** BCP40876, **DL:** 9261

| SERVICE | SIZE | MATERIAL | INSTALLED DATE | LOCATION | DETAILS |
|----------|-------|----------|----------------|-------------|----------------------------|
| WATER | 20MM | CU | | NO LOCATION | CONNECTION NUMBER MU100925 |
| SANITARY | 100MM | PVC | | NO LOCATION | CONNECTION # MU100925 |
| STORM | 100MM | PVC | | NO LOCATION | CONNECTION # MU100925 |

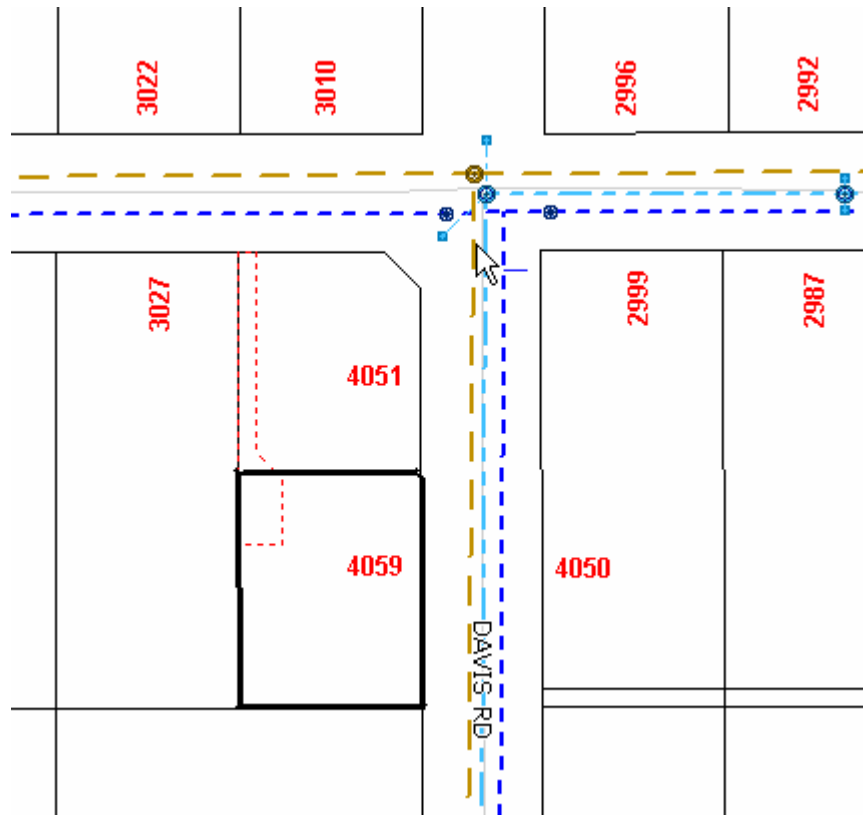

Accuracy not guaranteed unless confirmed by site inspection and/or investigation.
Connection location between main and property line only.