


### Lot Servicing

2181 LAURIER CRES

PID: 027942457

**Lot: C, Block: 121, Plan: 1268, DL: 343 (BB943983)**

SERVICE	SIZE	MATERIAL	INSTALLED DATE	LOCATION	DETAILS
WATER	20MM	CU		FR NW COR BLD 10.058M W 3.657M S (BLDG MOVED TO PCL B)	CONNECTION NUMBER 2711
SANITARY	100MM	PVC	30-Apr-2009	NEW SERVICE NO LOCATION	CONNECTION # 47060

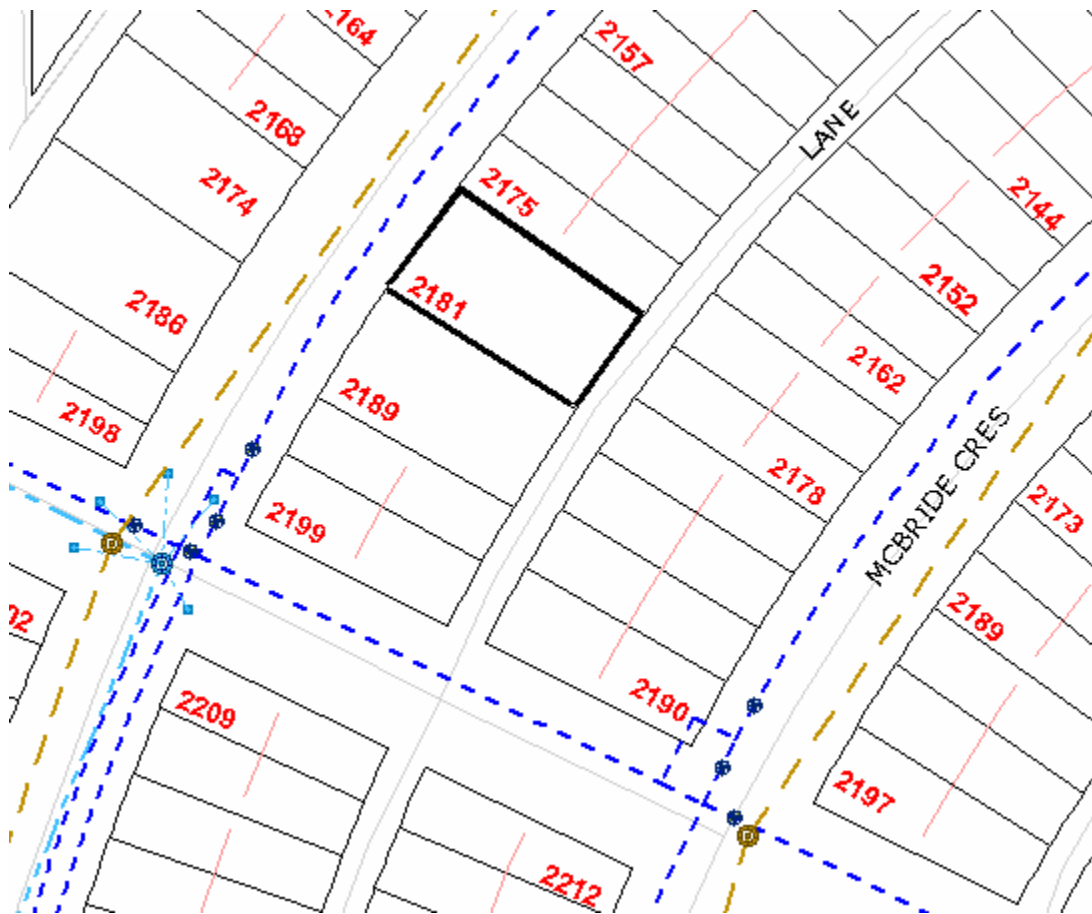

Accuracy not guaranteed unless confirmed by site inspection and/or investigation.  
Connection location between main and property line only.